

SURVEY &  
REMONUMENTATION

MAY 28 1997


COMMISSION  
For corners in

LAND CORNER RECORDATION CERTIFICATE  
Filing Requirement of Act 74, Mich. P.A. 1970

Shiawassee (County) Located in: Corner Code #

1. Public Land Survey	T 6N R 1E	D-7
	T R	
	T R	
	T R	
2. Property Controlling in Section	S T R	
	S T R	
3. Miscellaneous Property in Sec.	S T R	
	S T R	
4. Lot No.	Recorded Plat	
5. Private Claims		

RECORDED  
96 NOV 18 PM 3:38  
REGISTER OF DEEDS  
*Kaye Shultz*  
SHIAWASSEE COUNTY, MICH.  
Register of Deeds Stamp & File Number

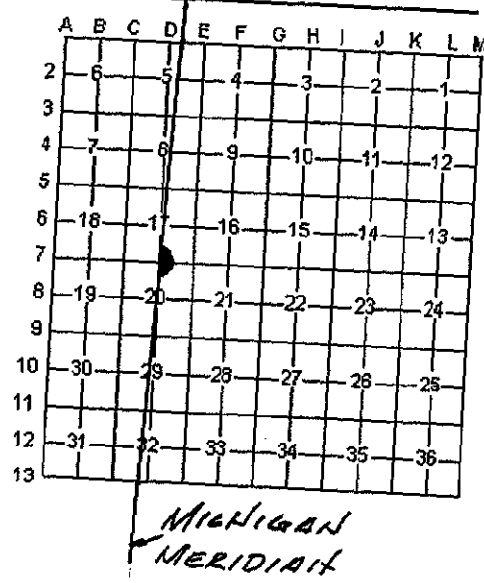

I, Mark L. VanRaemdonck, in a field survey on October 10, 1996, do hereby certify that under requirements of P.A. 74, Michigan P.A. of 1970, the corner points mentioned in lines 1 and 2 above were in conformance with regulations and rules therefore as required in the current manual of survey instructions of the United States Department of the Interior, Bureau of Land Management or by a decree of a Court of Law and/or that the current points mentioned in lines 3, 4 and 5 above were in conformance with the rules of the Michigan Board of Land Surveyors or by a Decree of a Court of Law; established, re-established, monumented, re-monumented, recovered, found as expressed below:

NOTE: Not more than 4 corners, all in the same town and range, may be recorded on this certificate.

A. Description of original monument and accessories and/or subsequent restoration:

- 1.) Original: Joseph Wampler, D.S. 1826  
Monument: Wood post  
Accessories: Tamarack 5 S50°W 39 lks.  
do 5 NE 41 lks.

Found no other record of this corner.

B. Description of corner evidence found and/or method applied in restoring or reestablishing corner:

I re-established this location using the single proportion method. Between corners D-5 and D-9 I set the point equidistant between corners D-5 and D-9 and on the Michigan Meridian between corners M-6 and M-7, T6N-R1W. This position is 0.12' North of being equidistant between D-6 and D-8 (non glo corners). I found a rerod with an unreadable cap 3 feet West of the centerline of Meridian Road 53.20 feet South of my re-established position. I ignored the rerod since I could not establish its origin. I accepted my position at the careful and faithful re-establishment of the original corner position. Excavation for the Harrison Marker provided no further evidence. There was no conflicting evidence.

C. Description of monument for corner and accessories to perpetuate locating the position of the corner:

Installed a standard Shiawassee County Harrison Marker Monument. The monument was stamped "Remon 24622" and witnessed by the following accessories:

- South 53.20 1/2" rerod 3'- West of centerline
- N25°W 25.00 Rerod & cap #24622 in West shoulder
- N40°E 25.00 Rerod & cap #24622 in East shoulder
- S25°W 25.00 Rerod & cap #24622 in West shoulder
- S40°W 25.00 Rerod & cap #24622 in East shoulder
- Extensive swamp and brush on both sides of road.



Signed by *Mark L. VanRaemdonck*  
Surveyor's Michigan License No. 24622

Date Nov. 11, 1996

FORM APPROVED BY MICHIGAN STATE BOARD OF LAND SURVEYORS. JAN 18, 19  
REVISED MAY 14, 1  
REVISED JAN., 1

LIBER 1R PG 169

APPROVED  
County Remonumentation  
Peer Review Group