

LAND CORNER RECORDATION CERTIFICATE
Filing Requirement of Act 74, Mich. P.A. 1970

**SURVEY &
 EMINENTMENT**

For corners in

Located in:

Corner Code #

Shiawassee
 (County)

JAN 16 2001

SECTION

1. Public Land Survey

T 7N R 3E K-2

2. Property Controlling
 In Section

S T R

3. Miscellaneous
 Property in Sec.

S T R

4. Lot No. _____ Recorded Plat _____

5. Private Claims _____

**Register of Deeds Stamp
 & File Number**

I, Mark L. VanRaemdonck, in a field survey on, January 5, 2000, do hereby certify that under requirements of P.A. 74, Michigan P.A. of 1970, the corner points mentioned in lines 1 and 2 above were in conformance with regulations and rules therefore as required in the current manual of survey instructions of the United States Department of the Interior, Bureau of Land Management or by a decree of a Court of Law and/or that the corner points mentioned in lines 3, 4 and 5 above were in conformance with the rules of the Michigan Board of Land Surveyors or by a Decree of a Court of Law; established, re-established, monumented, re-monumented, recovered, found as expressed below:

NOTE: Not more than 2 corners, all in the same town and range, may be recorded on this certificate.

A. Description of original monument and accessories and/or subsequent restoration:

1.) Original Joseph Wampler, D.S. April 1822.

Monument: Wood Post
 Accessories: W. Oak 36 N64W 17
 Elm 10 N28 1/2E 14

2.) Lyman Mason County Surveyor, County Surveyor's Book C, page 93 and Book D, page 86.
 December 6, 7 and 8, 1875.

Monument: Not given
 Accessories: No witnesses given.
 North 45.48 1/2 CH (3002.01 feet) to Northwest corner, Section 1)
 South 40.10 1/2 CH (2646.93 feet to Southwest corner, Section 1)

3.) Karol R. Piotrowski, L.C.R.C., recorded Liber 1, page 154, November 13, 1973.
 Monument: Set railroad spike in centerline of road and extension of East-West 1/4 line fences in Section 1 and 2.

Accessories: Fence post East 32.25'
 NW corner house #2360 S75°E 149.45'
 SW corner house #2360 S50°E 171.87'


Sketch shows a distance of 2650.97 feet South to corner K-3.

4.) John F. Quine, Certified Survey recorded Liber 6, page 647, December 29, 1993.

Monument: Found 3/4" solid iron stake 12" deep in gravel road.
 Accessories: 12029 cap atop iron stake West 33.00'
 Spike found W. face of 15" Elm S10°W 174.2'
 Centerline N. end of 12" RCP driveway culvert S10°E 112.3'
 Spike through #12029 cap, N. face of 10" Elm N85°W 32.75'
 Spike through #12029 cap, N. face of 12" Elm East 59.0'
 Center of telephone cable pedestal S85°E 30.1'
 NW corner Section 1 N00°53'39"E 2997.97'
 SW corner Section 1 S01°25'18"W 2650.85'

APPROVED
 County Remonumentation
 Peer Review Group

NCC 13 NOV 00

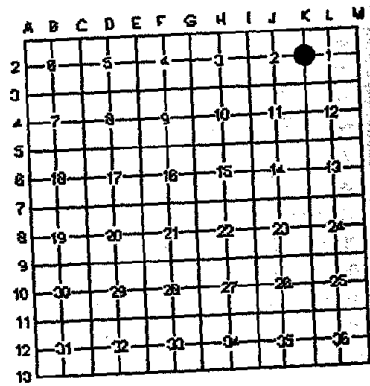

B. Description of corner evidence found and/or method applied in restoring or re-establishing corner:

Searched apparent corner location and found railroad spike as referenced in No. 3 and No. 4 above. Our measurement between corners K-1 and K-3 was the same as Lyman Mason's 1875 survey. Mason's distance between K-2 and K-3 was four feet shorter than our measurement between the railroad spike and K-3. Excavated a two foot diameter hole to original ground, at four feet South of railroad spike and found no evidence. Accepted the location of the railroad spike as the original corner position based on the best available evidence. Found a 3/4" steel stake below the railroad spike.

C. Description of monument for corner and accessories to perpetuate locating the position of the corner:


Replaced the railroad spike and 3/4" steel stake with a standard Shiawassee County Harrison marker monument. The marker is stamped "Remon P.S. 24622" and is witnessed with the following accessories:

West 32.78' Nail and Cap #12018 in N. face dead tree
 S85°E 30.17' Top cen. Tele. Cable Box
 S55°E 32.28' Set Nail & Tag #24622 NW face 12" Pine
 S30°E 50.40' Set Nail & Tag #24622 SW face 6" Pine
 West 33.00' Road & Cap #12029

Signed by

Surveyor's Michigan License No. 24622

Date 10-17-00

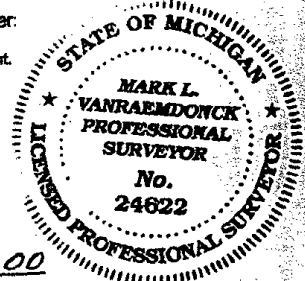

3043885
 Page: 1 of 1
 11/17/2000 09:33A
 L-1 P-338

Kaye Grubbs - Shiawassee Co. REMON

FORM APPROVED BY MICHIGAN STATE BOARD OF LAND SURVEYORS JAN 18, 1971
 REVISED MAY 14, 1975
 REVISED JAN. 1985