

LAND CORNER RECORDATION CERTIFICATE

Filing Requirement of Act 74, Mich. P.A. 1970

For corners in

Shiawassee

(County)

Located in:

Corner Code #

SURVEY &
MONUMENTATION

JAN 16 2001

SECTION

Register of Deeds Stamp
& File Number

1. Public Land Survey

T 7N R 3E

M-4

T R

T R

T R

S T R

2. Property Controlling
In Section

S T R

3. Miscellaneous
Property in Sec.

S T R

4. Lot No.

Recorded Plat

5. Private Claims

I, Mark L. VanRaemdonck, in a field survey on, January 5, 2000, do hereby certify that under requirements of P.A. 74, Michigan P.A. of 1970, the corner points mentioned in lines 1 and 2 above were in conformance with regulations and rules therefore as required in the current manual of survey instructions of the United States Department of the Interior, Bureau of Land Management or by a decree of a Court of Law and/or that the corner points mentioned in lines 3, 4 and 5 above were in conformance with the rules of the Michigan Board of Land Surveyors or by a Decree of a Court of Law; established, re-established, monumented, re-monumented, recovered, found as expressed below:

NOTE: Not more than 2 corners, all in the same town and range, may be recorded on this certificate.

A. Description of original monument and accessories and/or subsequent restoration:

1.) Original: Joseph Wampler, D.S., no date given, Circa 1823.

Monument: wood post

Accessories: Tam 7 N57°W 9

Do 5 S61°E 5

2.) Lyman Mason, County Surveyor, County Surveyor's Book C, pg. 210, March 25 & 26, 1879.

Monument: not given

Accessories: not given, distance to M-5 40.05 1/2 CH (2648.63')

3.) H.C. Mein (not county surveyor), County Surveyor's Book E, pg. 157, November 29 & 30, 1886.

Monument: not given

Accessories: Elm 12 S13°W 114

4.) Name of surveyor not given, County Road field Book 20, pg. 74, 4/12/1919.

Monument: Found old wooden stake, placed 3/4" iron bar and three stones.

Accessories: Elm 26° S15°10'W 95' 10"

Elm 3° N58°25'W 31' 9"

Continued on reverse.

APPROVED

County Remonumentation
Peer Review Group

NCC
13 NOV 00

B. Description of corner evidence found and/or method applied in restoring or re-establishing corner:

Found a rod and cap as referenced in No. 5, 6 and 7 above. Excavated to 2 feet below asphalt surface and found 3/4" bar and three stones. Our measured distance to M-3 is 2635.5 feet and the distance of M-5 is 2604.70 feet, which compares closely with road plan distances of 2633 and 2603.9 feet respectively. I accepted this location as the perpetuation of the original corner location.

C. Description of monument for corner and accessories to perpetuate locating the position of the corner:

Removed rod and cap, 3/4" bar, and stones and replaced them with a standard Shiawassee County harrison marker monument. The marker is stamped "Remon P.S. 24622" and is witnessed by the following accessories:

North 2.94'
N40°E 36.20'
N25°W 30.00'
S25°W 30.00'

Harrison marker @ corner A-4, T7N-R4E
Found REI N&T NW face 14" Poplar
Set R&C #24622
Set R&C #24622

Signed by

Surveyor's Michigan License No. 24622

Date 10-26-00

FORM APPROVED BY MICHIGAN STATE BOARD OF LAND SURVEYORS JAN 18, 1971
REVISED MAY 14, 1975
REVISED JAN, 1985



Kaye Grubba - Shiawassee Co.

REMON

3043879

Page 1 of 2

11/17/2000 09:33A

L-1 P-332




A. Description of original monument and accessories and/or subsequent restoration:

5.) Name of surveyor not given, County Road plans for Geack Road, Circa 1919.
Monument: found wooden stake, drove 3/4" iron bar
Accessories: stationing gives a distance of 2633 feet to corner M-3 and 2603.9 feet to corner M-5.
Also, 292.5 feet to 18" concrete arch culvert at Stevens Drain

6.) Jan S. Fokens, Certified Survey, recorded Liber 2, pg. 357, August 24, 1976.
Monument: found 1/2" rerod, raised to road surface with rerod and cap RLS 11192
Accessories: East 33.00' Rerod/RLS 11192 cap
West 33.00' Rerod/RLS 11192 cap

7.) Mark L. VanRaemdonck, Certified Survey, recorded Liber 8, pg. 101, December 5, 1997
Monument: Found rerod and cap
Accessories: East 33.00' R/C #24622
S60°W 23.85' N. end 12" conc. culv.
S60°E 24.15' N. end 12" conc. culv.
S35°E 41.80' S. end 12" conc. culv.

8.) Mark L. VanRaemdonck, Certified Survey, recorded Liber 8, pg. 463, 6/20/1999.
Monument and accessories are the same as No. 7 above.

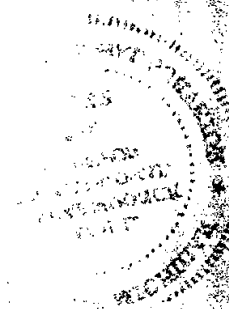

3043879
Page: 2 of 2
11/17/2000 09:33A
L-1 P-332

Kaye Grubba - Shawansee Co. REMON

11/17/2000 09:33A
11/17/2000 09:33A