

LAND CORNER RECORDATION CERTIFICATE
Filing Requirement of Act 74, Mich. P.A. 1970

SURVEY &
 MONUMENTATION

For corners in

Shiawassee
 (County)

Located in:

Corner Code #

JAN 16 2001

SECTION

- | | | |
|-------------------------|--|---------------|
| 1. Public Land Survey | T. <u>7N</u> R. <u>3E</u> | <u>M-5</u> |
| | T. <u> </u> R. <u> </u> | <u> </u> |
| | T. <u> </u> R. <u> </u> | <u> </u> |
| | T. <u> </u> R. <u> </u> | <u> </u> |
| 2. Property Controlling | S. <u> </u> T. <u> </u> R. <u> </u> | <u> </u> |
| in Section | S. <u> </u> T. <u> </u> R. <u> </u> | <u> </u> |
| 3. Miscellaneous | S. <u> </u> T. <u> </u> R. <u> </u> | <u> </u> |
| Property in Sec. | S. <u> </u> T. <u> </u> R. <u> </u> | <u> </u> |
| 4. Lot No. _____ | Recorded Plat _____ | |
| 5. Private Claims _____ | | |

**Register of Deeds Stamp
 & File Number**

I, Mark L. VanRaemdonck, in a field survey on, January 5, 2000, do hereby certify that under requirements of P.A. 74, Michigan P.A. of 1970, the corner points mentioned in lines 1 and 2 above were in conformance with regulations and rules therefore as required in the current manual of survey instructions of the United States Department of the Interior, Bureau of Land Management or by a decree of a Court of Law and/or that the corner points mentioned in lines 3, 4 and 5 above were in conformance with the rules of the Michigan Board of Land Surveyors or by a Decree of a Court of Law; established, re-established, monumented, re-monumented, recovered, found as expressed below:

NOTE: Not more than 2 corners, all in the same town and range, may be recorded on this certificate.

A. Description of original monument and accessories and/or subsequent restoration:

1.) Original: Joseph Wampler, D.S., no date given, Circa 1823.
 Monument: wood post
 Accessories: Hickory 11 N55°W 17
 Ash 9 N01°E 31

2.) H.C. Main, (not county surveyor), County Surveyor's Book E, pg. 157, November 29 & 30, 1886.
 Monument: stake
 Accessories: none given

3.) E.F. Joslin, County Surveyor, Field Book X, pg. 9, 4/12/1905.
 Monument: drove 3/4" iron bolt beside stake
 Accessories: Elm 18° N10°W 123 1/4 LKS

4.) Name of surveyor not given, County Road Field Book 20, pg. 74, 4/12/1919.
 Monument: Found iron bolt, stones and wooden stake
 Accessories: Elm 18° N08 1/4°W 81 1/2
 S. leg of power tower N42°05'E 40' 10"

Continued on reverse.

| | A | B | C | D | E | F | G | H | I | J | K | L | M |
|----|----|----|----|----|----|----|---|---|---|---|---|---|---|
| 2 | 6 | 5 | 4 | 3 | 2 | | | | | | | | |
| 3 | | | | | | | | | | | | | |
| 4 | 7 | 8 | 9 | 10 | 11 | 12 | | | | | | | |
| 5 | | | | | | | | | | | | | |
| 6 | 13 | 17 | 16 | 15 | 14 | 13 | | | | | | | |
| 7 | | | | | | | | | | | | | |
| 8 | 19 | 20 | 21 | 22 | 23 | 24 | | | | | | | |
| 9 | | | | | | | | | | | | | |
| 10 | 30 | 29 | 28 | 27 | 26 | 25 | | | | | | | |
| 11 | | | | | | | | | | | | | |
| 12 | 31 | 32 | 33 | 34 | 35 | 36 | | | | | | | |
| 13 | | | | | | | | | | | | | |

APPROVED

County Remonumentation
 Peer Review Group

NCC
 13 NOV 00


B. Description of corner evidence found and/or method applied in restoring or re-establishing corner:

Found rerod and cap mentioned in No. 8 above. Located power pole and Southwest leg of power tower leg, as mentioned in No. 7 above. Offset and removed rerod and cap and excavated a one foot diameter hole. At one foot below surface and 0.5 feet West of rerod, Found a 1/2" pipe. Excavated around pipe and found evidence of wood stake. I accepted the location of the 1/2" pipe as the perpetuation of the original corner location.

C. Description of monument for corner and accessories to perpetuate locating the position of the corner:

Removed rerod and cap and 1/2" pipe. Replaced the 1/2" pipe with a standard Shiawassee County harrison marker monument. The marker is stamped "Remon P.S. 24622" and is witnessed by the following accessories:

N25°W 30.0' Set R&C #24622
 S30°W 30.0' Set R&C #24622
 S40°E 92.36' Set N&T SW face P/Pole
 N35°E 39.50' S. leg power tower

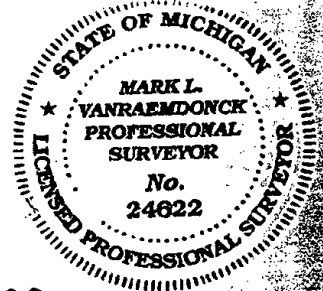

Signed by

Mark L. VanRaemdonck

Date 10-26-00

Surveyor's Michigan License No. 24622

FORM APPROVED BY MICHIGAN STATE BOARD OF LAND SURVEYORS JAN 18, 1971
 REVISED MAY 14, 1975
 REVISED JAN, 1983



Kaye Grubba - Shiawassee Co. REMON

3043880
 Page: 1 of 2
 11/17/2000 09:39A
 L-1 P-333

A. Description of original monument and accessories and/or subsequent restoration:

5.) O.M. Elliot, Field Book 12, pg. 53, no date given.

Monument: not given

Accessories: Elm 30° N10°W 81.5'

Top nut of SW brace to power tower 39.5'

6.) Name of surveyor not given. County Road plans for Geeck Road, circa 1919.

Monument: found iron bolt and stones

Accessories: from stationing, the distance to corner M-4 was 2603.9 feet

7.) O.M. Elliot's Book 32, pg. 74, Consumers Power Co., 1959.

Monument: 1/2" gas pip at surface of road

Accessories: SW tower leg NE 39.2'

Iron fence post W. 30.2'

Power Pole SE 92.2'

8.) Jan S. Fokens, Certified Survey, recorded Liber 2, pg. 357, August 24, 1976.

Monument: Found engine valve - reset with rerod & RLS 11192 cap

Accessories: East 33.00' Rerod/RLS 11192 cap

NW 73.79' Rerod/RLS 11192 cap

