

# SURVEY & REMONUMENTATION

NOV 10 1997

COMMISSION

## LAND CORNER RECORDATION CERTIFICATE Filing Requirement of Act 74, Mich. P.A. 1970

RECORDED

97 OCT 15 PM 12: 14

REGISTER OF DEEDS

*Kyle Schutte*  
SHIAWASSEE COUNTY, MICH.

For corners in  
Shiawassee  
(County)

Located in:

Corner Code #

Fairfield Twp

1. Public Land Survey

T 8N R 1E

D-6

2. Property Controlling  
in Section

S T R

3. Miscellaneous  
Property in Sec.

S T R

4. Lot No. \_\_\_\_\_, Recorded Plat \_\_\_\_\_

5. Private Claims \_\_\_\_\_

I, Wendy A. Papineau, in a field survey on June 1997, do hereby certify that under requirements of P.A. 74, Michigan P.A. of 1970, the corner points mentioned in lines 1 and 2 above were in conformance with regulations and rules therefore as required in the current manual of survey instructions of the United States Department of the Interior, Bureau of Land Management or by a decree of a Court of Law and/or that the corner points mentioned in lines 3, 4 and 5 above were in conformance with the rules of the Michigan Board of Land Surveyors or by a Decree of a Court of Law; established, re-established, monumented, re-monumented, recovered, found as expressed below:

NOTE: Not more than 4 corners, all in the same town and range, may be recorded on this certificate.

A. Description of original monument and accessories and/or subsequent restoration:

D-6 Closing 1/4 Corner, Section 17, T8N-R1E

This position was not established by original government survey.

B. Description of corner evidence found and/or method applied in restoring or reestablishing corner:

D-6 Closing 1/4 Corner, Section 17, T8N-R1E

Found no evidence of corner being established or used by surveyors. Established the corner position on the Michigan Meridian at a midpoint between the Closing Section corners of Section 17.

There appears to be no conflicting evidence and this position is accepted as a careful and faithful determination of the position of the corner.

Approved by the Shiawassee County Remonumentation Peer Review Group September 4, 1997.

C. Description of monument for corner and accessories established to perpetuate locating the position of the corner:

D-6 Closing 1/4 Corner, Section 17, T8N-R1E


Placed a standard Harrison monument on the Michigan Meridian in a monument box  
N50E 53.65' Set N&T #39096 SE fc 10" Mulberry  
S35E 59.08' Set N&T #39096 SW fc 18" Box Elder  
S60E 33.40' Set N&T #39096 SW fc 20" Box Elder  
N60W 19.60' Set 1/2" rerod in forward slope of ditch bank

|    | A  | B | C  | D | E  | F | G  | H | I  | J | K  | L | M |
|----|----|---|----|---|----|---|----|---|----|---|----|---|---|
| 1  |    |   |    |   |    |   |    |   |    |   |    |   |   |
| 2  | 6  |   | 5  |   | 4  |   | 3  |   | 2  |   | 1  |   |   |
| 3  |    |   |    |   |    |   |    |   |    |   |    |   |   |
| 4  | 7  |   | 8  |   | 9  |   | 10 |   | 11 |   | 12 |   |   |
| 5  |    |   |    |   |    |   |    |   |    |   |    |   |   |
| 6  | 18 |   | 17 |   | 16 |   | 15 |   | 14 |   | 13 |   |   |
| 7  |    |   |    |   |    |   |    |   |    |   |    |   |   |
| 8  | 19 |   | 20 |   | 21 |   | 22 |   | 23 |   | 24 |   |   |
| 9  |    |   |    |   |    |   |    |   |    |   |    |   |   |
| 10 | 30 |   | 29 |   | 28 |   | 27 |   | 26 |   | 25 |   |   |
| 11 |    |   |    |   |    |   |    |   |    |   |    |   |   |
| 12 | 31 |   | 32 |   | 33 |   | 34 |   | 35 |   | 36 |   |   |
| 13 |    |   |    |   |    |   |    |   |    |   |    |   |   |

APPROVED

County Remonumentation  
Peer Review Group

*NCC*  
*10 OCT 97*

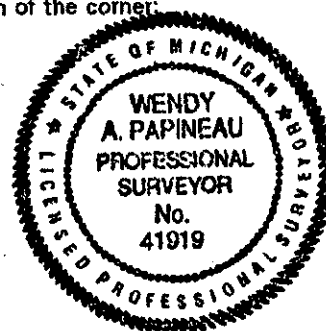

Signed by Wendy A. Papineau

Date 10-07-97

Surveyor's Michigan License No. 41919

FORM APPROVED BY MICHIGAN STATE BOARD OF LAND SURVEYORS, JAN. 28, 1971  
REVISED MAY 14, 1976  
REVISED JAN., 1983  
ADAPTED FOR WORD PROCESSING MARCH, 1983

LIBER 1R PG 200

A PORTION OF

THE

# MICHIGAN MERIDIAN

A

RETRACEMENT AND REMONUMENTATION PROJECT  
FOR  
CLINTON AND SHAWASSEE COUNTIES, MICHIGAN  
MARCH - SEPTEMBER 1997

BY  
**ROWE ENGINEERING, INC.**  
112 E. McARTHUR STREET  
CORUNNA, MI 48807

BEARINGS ARE BASED ON A  
PREVIOUS REMONUMENTATION  
PROJECT JANUARY THROUGH  
MAY, 1996 BY ROWE ENGINEERING, INC.  
JOB NO. S-4531, AND ALSO A SOLAR  
OBSERVATION AT THE NORTH END OF  
THE 1997 REMONUMENTATION PROJECT



SHEET 2 OF 3 SHEETS

NOV 10 1997  
COMMISSION

SURVEY &  
REMONUMENTATION

CLINTON COUNTY

DUPLAIN TOWNSHIP  
(T8N-R1W)

CLINTON COUNTY

ELBA TOWNSHIP  
(T8N-R1W)

GRATIOT COUNTY

SHAWASSEE COUNTY

FAIRFIELD TOWNSHIP  
(T8N-R1E)

SAGINAW COUNTY

CHAPIN TOWNSHIP  
(T8N-R1E)

