

SURVEY &
REMONUMENTATION

NOV 03 1998

SECTION

1998 REMONUMENTATION PROGRAM
LAND CORNER RECORDATION CERTIFICATE
Filing Requirement of Act 74, Mich. P.A. 1970

For corners in

Shiawassee
(County)

Located In:
Hazelton Twp

Corner Code #



3007728
Page: 1 of 2
10/27/1998 03:22P
Lb-1 Pg-281

1. Public Land Survey T 8 N R 4 E K - 9
T R
T R
T R
2. Property Controlling S T R
in Section S T R
3. Miscellaneous S T R
Property in Sec. S T R

Register of Deeds Stamp & File Number

4. Lot No. _____ Recorded Plat _____
5. Private Claims _____

I, John H. Rauser, P.S., in a field survey on February & September 19 98, do hereby certify that under requirements of P.A. 74, Michigan P.A. of 1970, the corner points mentioned in lines 1 and 2 above were in conformance with regulations and rules therefore as required in the current manual of survey instructions of the United States Department of the Interior, Bureau of Land Management or by a decree of a Court of Law and/or that the corner points mentioned in lines 3, 4 and 5 above were in conformance with the rules of the Michigan Board of Land Surveyors or by a Decree of a Court of Law; established, re-established, monumented, re-monumented, recovered, found as expressed below:

NOTE: Not more than 2 corners, all in the same town and range, may be recorded on this certificate.

	A	B	C	D	E	F	G	H	I	J	K	L	M
1													
2	6	5		4	3			2		1			
3													
4	7	8	9	10	11	12							
5													
6	18	17	16	15	14	13							
7													
8	19	20	21	22	23	24							
9													
10	30	29	28	27	26	25							
11													
12	31	32	33	34	35	36							
13													

A. Description of original monument and accessories and/or subsequent restoration:

K - 9 Section Corner, Sections 23,24,25,26, T8N-R4E, Hazelton Township

- 1822 Wood post placed by Joseph Wampler D.S.: Beech 10 N30W, 10 links
Beech 16 S20W, 26 links
1876 Survey by Lyman Mason, C.S. referenced post, Apple tree 5 S45-10E, 97.5 links, Measured 39.55 ch between K-9 and L-9.
1972 CPCo Un-recorded survey by E J McCombs, P.S. # 10696, F.B. 1270, DWG No S-F17561, Sheet 4, Rev.A; Set boat spike. Measured 2616.89' (39.65 ch.) between K-9 and L-9, Measured 2647.99' (40.12 ch.) between K-9 and K-10.
S45W 46.5' T. Pole
N45E 46.85' T. Pole
N45W 40.22' Rd. Sign

APPROVED

County Remonumentation
Peer Review Group

23 OCT 98
NCC

Continued on back :

B. Description of corner evidence found and/or method applied in restoring or reestablishing corner:

K - 9 Section Corner, Sections 23,24,25,26, T8N-R4E, Hazelton Township

Found 1/2" re-rod & cap # 20709 in monument box, and 1 accessory from 1972 (T. Pole to NE at 46.85'), and 1 accessory from 1994 (N fc sign post to SE at 44.76'), and 3 accessories from 1995 (rod # 20709 to NW at 32.20', rod # 20709 to SE at 31.78', rod # 20709 to SW at 34.45'). Measured South 2648.01' (40.12 ch.) to K-10 (1822 GLO 40.00 ch., 1972 rec. 2647.99'), measured East 2616.77' (39.65 ch.) to L-9 (1822 GLO 39.89 ch., 1876 C.S. rec. 39.55 ch., 1972 rec. 2616.89'). We accept the position of the 1/2" re-rod in a monument box as the best available evidence of the position of the original government corner


C. Description of monument for corner and accessories established to perpetuate locating the position of the corner:

K - 9 Section Corner, Sections 23,24,25,26, T8N-R4E, Hazelton Township

Set a standard 20" Harrison monument at the position approved by the Shiawassee County peer review group

- N45W 32.24' Found rod & cap # 20709 on ditch bank S30E 44.14' N fc stop sign post
N40W 35.85' E - edge stop/road sign post S45W 34.48' Found rod & cap # 20709 on ditch bank
N40E 55.93' Top center E-end 12" cmp
N45E 47.06' Found nail & tag NW fc cut-off T/P
S45E 31.81' Found rod & cap # 20709 in ditch

Signed by John H. Rauser
Surveyor's Michigan License No. 39096

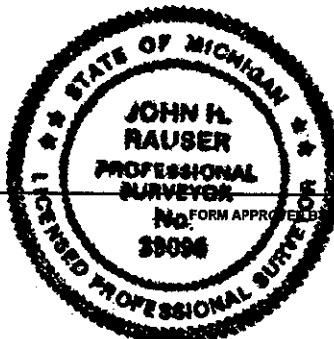

Date 10/21/98

FORM APPROVED BY MICHIGAN STATE BOARD OF LAND SURVEYORS, JAN. 28, 1971
REVISED MAY 14, 1976
REVISED JAN., 1983
ADAPTED FOR WORD PROCESSING MARCH, 1993

A. Continued:

- 1972 Surveys & LCRC by David T. Rowe, P.S. # 11192, L. 1, P. 79, and un-recorded survey Job No. F-3668-72-A, LCRC, L. 1, P. 42; Found ½ " bolt in pavement.
 N45E 46.83' Red nail & tag in P.P. NE cor. Byron & Riley Rd.
 N30W 34.82' Red bolt in South side of stop sign NW cor. Byron & Riley Rd.
 S45W 46.53' Red nail & tag in P. P. SW cor. Byron & Riley Rd.
- 1976 CPCo survey by E. J. McComb, P.S. # 10696, L. 2, Pgs. 383-384; Set boat spike.
 S45W 46.5' T. pole
 N45E 46.85' T. pole
 N45W 40.22' Rd. Sign
- 1978 Survey by Jan S. Fokens, P.S. # 21567, L. 3, Pgs. 23-24; No description of the monument given.
 N45E 46.83' Nail & Tag in P. P.
 S45W 46.53' Nail & Tag in P.P.
- 1979 Un-recorded survey by Jan S. Fokens, P.S. # 21567, Job # F-6250-79; ½ " bolt in pavement.
 N45E 46.83' Red nail & tag in P.P. NE cor. Byron & Riley Rd.
 N30W 34.82' Red bolt in South side of stop sign NW cor. Byron & Riley Rd.
 S45W 46.53' Red nail & tag in P. P. SW cor. Byron & Riley Rd.
- 1984 Survey by David T. Rowe, P.S. # 11192, L. 4, P. 262; No description of the monument given.
 N45E 46.83' Nail & tag in P.P.
 S45W 46.53' Nail & tag in P.P.
- 1994 Survey by Mark L. VanRaemdonck, P.S. # 24622, L. 6, Pgs. 751-752; Found bolt. Measured 2623.70' (39.75 ch.) between K-9 and J-9.
 N40E 46.82' Nail & tag NW Fc cut off T.P.
 S45E 43.73' Top cen. tel. ped.
 S30E 44.76' N Fc sign post
 N45W 44.46' E Fc road sign post
- 1995 Survey by Paul N. Brown, P.S. # 33134, L. 7, P. 286; Set rod & cap # 20709
 N45W 32.20' Set rod w/cap #20709 in ditch bank
 N40E 46.63' Fnd nail & tag in NW Fc of a cut off T/P
 S45E 31.78' Set rod w/cap #20709 in ditch
 S45W 34.45' Set rod w/cap #20709 in ditch bank
- 1996 LCRC by Mark L. VanRaemdonck, P.S. # 24622, L. 2, P. 949; Found Rowe Engineering rerod and cap, placed monument box over found iron.
 N40E 46.82' N&T NW Fc cut off T.P.
 S30E 44.76' N Fc sign post
 N30W 35.85' E edge sign post
 N35E 56.00' Top center 14" CMP E end

SURVEY &
 REMONUMENTATION

NOV 03 1998

SECTION



3007728
 Page: 2 of 2
 10/27/1998 03:22P

Kaye Grubba - Shiawassee Co. REMON

Lb-1 Pg-281