

SURVEY &
REMONUMENTATION

DEC 02 1993

1993 REMONUMENTATION PROGRAM
LAND CORNER RECORDATION CERTIFICATE
Filing Requirement of Act 74, Mich. P.A. 1970

COMMISSION

ARBELA TOWNSHIP

For corners in

TUSCOLA

(County)

Located in:

Corner Code #

1. Public Land Survey

T 10 N R 7 E

B-13

2. Property Controlling
in Section

S T R

3. Miscellaneous
Property in Sec.

S T R

4. Lot No. Recorded Plat

5. Private Claims

I, JONATHAN M. FIELD, in a field survey on OCTOBER 19 93, do hereby certify that under requirements of P.A. 74, Michigan P.A. of 1970, the corner points mentioned in lines 1 and 2 above were in conformance with regulations and rules therefore as required in the current manual of survey instructions of the United States Department of the Interior, Bureau of Land Management or by a decree of a Court of Law and/or that the corner points mentioned in lines 3, 4 and 5 above were in conformance with the rules of the Michigan Board of Land Surveyors or by a Decree of a Court of Law; established, re-established, monumented, re-monumented, recovered, found as expressed below:

NOTE: Not more than 4 corners, all in the same town and range, may be recorded on this certificate.

A. Description of original monument and accessories and/or subsequent restoration:

1821 GLO - WAMPLER, D.S. - SET 1/2 MILE POST; BIRCH 5" N88E 13 LKS, BIRCH 8" S11E 17 LKS.
19?? R.J.BLACK, P.S. #3384; UNRECORDED SURVEY FOR LOUIS P. GAUTHIER - NO OBJECT STATED, NO WITS GIVEN
19?? FLINT SURVEYING; UNRECORDED SURVEY - NO OBJECT STATED, NO WITS GIVEN
1971 AMERICAN CIVIL ENG.; UNRECORDED SURVEY JOB NO. 5122-35-1 - NO OBJECT STATED, NO WITS GIVEN
1971 ROWE ENG. - KELLY; WIT CARD - FND 1/2" ROD BENT, REPLACED W/ T-IRON; S10E 32.04' N/C TWIN 12" OAK, S35W 39.12' N/C 12" OAK, S40W 44.92' N/C 12" OAK, WEST 114.00' C/L MONTLE RD
1971 ROWE ENG. - ROWE, P.S. #11192; SURVEY L.1, PG.603-604 - WITS SAME AS REI WIT CARD CITED ABOVE
1971 ROWE, P.S.#11192; LCRC PG 20 - FND 1/2" ROD BENT, REPLACED W/ T-IRON; SAME WITS REI SURVEY CITED ABOVE
1981 CHMP - MILLER, P.S. #12024; SURVEY L.539, PG.170-172 - NO OBJECT STATED, NO WITS GIVEN

B. Description of corner evidence found and/or method applied in restoring or reestablishing corner:

1993 ROWE ENG. - FIELD, P.S.#37276; FND T-IRON 1' BELOW GRADE, AT C/L GRAV RD E-W; 3 PREV WITS VERIFY POSITION SAME AS REI 1971 WIT CARD CITED IN "A" ABOVE; DUG 3'X5'X3' DEEP FND NO OTHER EVIDENCE; NO EVIDENCE OF OCCUPIED LINE TO NORTH

ACCEPTED T-IRON AS BEST EVIDENCE OF ORIGINAL CORNER POSITION

SEE ALSO BACK OF THIS FORM

C. Description of monument for corner and accessories established to perpetuate locating the position of the corner:

B-13 REMOVED T-IRON, SET STANDARD MONUMENT (5/8"X36" ROD W/ BRASS CAP IN CONC)
S64°E, 130.17' SET NAIL W/REMON TAG N. FACE P.POLE
S12°W, 56.14' SET NAIL W/REMON TAG E. FACE P.POLE (ALSO RR SPIKE IN N. FACE)
S57°W, 39.18' SET NAIL W/REMON TAG N. FACE 14" OAK
S62°W, 44.89' SET NAIL W/REMON TAG N. FACE 14" OAK
WEST, 111.88' FND 1/2" ROD IN MON BOX

Signed by

Jonathan M. Field

Date

10-27-93

Surveyor's Michigan License No.

37276

APPROVED

10-18-93


7700
JMF

RECEIVED FOR RECORD
LIBER NO. PAGE NO. 31
FILING NO. Arbela Twp.
93 NOV -8 PM 4:03
VICTORIA H. HALL
TUSCOLA COUNTY
REGISTER OF DEEDS


Register of Deeds Stamp & File Number

	A	B	C	D	E	F	G	H	I	J	K	L	M
1													
2	6		5		4		3		2		1		
3													
4	7		8		9		10		11		12		
5													
6	18		17		16		15		14		13		
7													
8	19		20		21		22		23		24		
9													
10	30		29		28		27		26		25		
11													
12	31		32		33		34		35		36		
13													


COPY

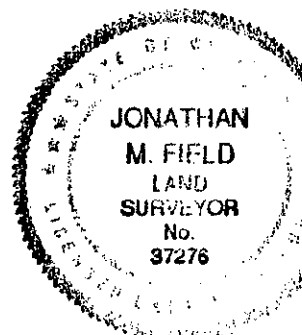

COPY

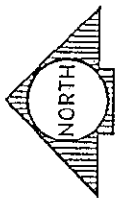

SECTION 31
TION-R7E

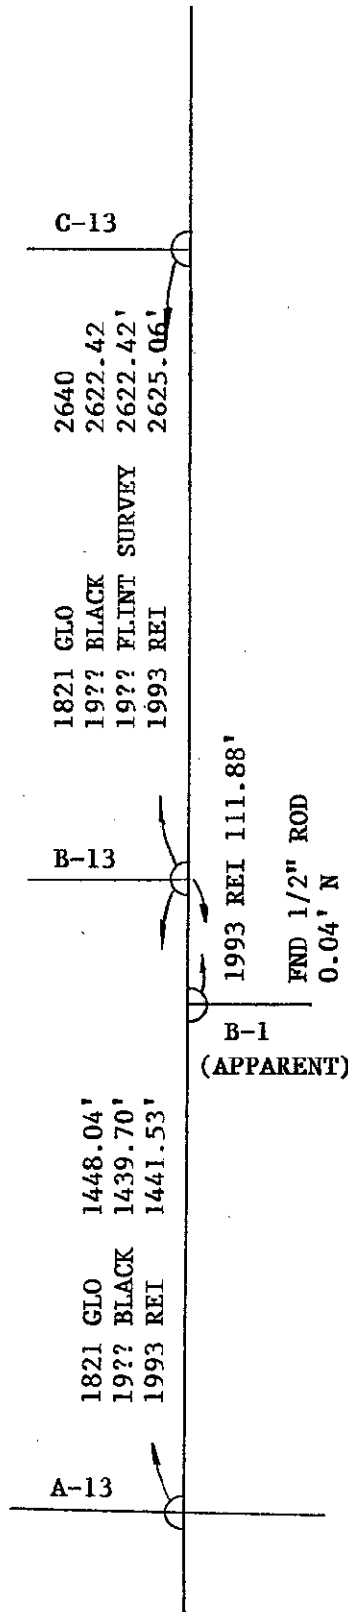

SECTION 6
T9N-R7E