

SURVEY & REMONUMENTATION

DEC 02 1993

COMMISSION

1993 REMONUMENTATION PROGRAM  
LAND CORNER RECORDATION CERTIFICATE

Filing Requirement of Act 74, Mich. P.A. 1970

ARBELA TOWNSHIP

For corners in

TUSCOLA

(County)

Located In:

Corner Code #

1. Public Land Survey

T 10 N R 7 E

K-13

2. Property Controlling  
in Section

S

T R

3. Miscellaneous  
Property in Sec.

S

T R

4. Lot No. , Recorded Plat

5. Private Claims

RECEIVED FOR RECORD  
LIBER NO. PAGE NO. 90  
FILING NO. Arbela Top.  
93 NOV -8 PM 4:03  
VIRGINIA H. HALLARD  
TUSCOLA COUNTY  
REGISTER OF DEEDS

Register of Deeds Stamp & File Number

I, JONATHAN M. FIELD, in a field survey on OCTOBER 19 93, do hereby certify that under requirements of P.A. 74, Michigan P.A. of 1970, the corner points mentioned in lines 1 and 2 above were in conformance with regulations and rules therefore as required in the current manual of survey instructions of the United States Department of the Interior, Bureau of Land Management or by a decree of a Court of Law and/or that the corner points mentioned in lines 3, 4 and 5 above were in conformance with the rules of the Michigan Board of Land Surveyors or by a Decree of a Court of Law, established, re-established, monumented, re-monumented, recovered, found as expressed below:

NOTE: Not more than 4 corners, all in the same town and range, may be recorded on this certificate.

	A	B	C	D	E	F	G	H	I	J	K	L	M
1													
2	6	5	4	3	2	1							
3													
4	7	8	9	10	11	12							
5													
6	18	17	16	15	14	13							
7													
8	19	20	21	22	23	24							
9													
10	30	29	28	27	26	25							
11													
12	31	32	33	34	35	36							
13													

A. Description of original monument and accessories and/or subsequent restoration:

1821 GLO - WAMPLER, D.S.; SET POST; BIRCH 8" S45E 4 LKS, ASH 11" N54W 26 LKS  
1888 TESKEY, C.S.; FLINT STONE 10"X22" & CROCKERY BY STAKE AND DISTANCE FROM CORNER K-1 T9N-R7E W.OAK 10" N77W 140 LKS  
1959 R.J.BLACK, P.S. #3384; WIT CARD - FND POINTED STONE SET 5/8" IRON BESIDE; S45E 45.41' T.POLE, N45W 123.69' SE COR HSE, S53W 87.91' SPIKE IN 24" ELM, N35E 67.80' T.POLE  
1977 GENESEE CO. RD. COMM.; WIT CARD #123 - STONE; NE 65.12' T.P., SE 39.38' T.P., SW 159.5' NE COR HSE, NW 130.13' SE COR HSE WEST 43.8' K-1,T9N-R7E  
1971 ROWE ENG.; UNRECORDED SURVEY JOB NO. F-3303-71-S - FND MON BOX; WEST 43.80' TO K-1,T9N-R7E  
1974 MITCHELL, P.S.#6936; LCRC PG.43 - FND MON BOX W/ WOOD HUB; N75W 89.85' 20" OAK, S65W 80.15' T.POLE, S45W 82.80' R/W MARKER, S45E 39.20' P & T.POLE  
1988 DUNTON LAND SURVEYING - DUNTON, P.S. #23503; SURVEY L.579,PG.1008-1009 - FIELD NOTES SHOW FND WOOD STAKE IN MON BOX; DIST OF 44'+/- SHOWN TO K-1,T9N-R7E  
1988 CORNERSTONE SURVEYING - BONNO, P.S. #32332; SURVEY L.2330,PG.79-80 (GENESEE CO.) FND WOOD STAKE IN MON BOX; DIST OF 43.86' GIVEN TO K-1,T9N-R7E

SECTION A CONTINUED ON BACK

B. Description of corner evidence found and/or method applied in restoring or reestablishing corner:

1993 ROWE ENG. - FIELD, P.S. #37276; FND 1/2" ROD IN MON BOX 2'E OF EXTENDED C/L OF ASPH RD N. & ON C/L OF GRAV RD E-W; FND 4 PREV WITS WHICH VERIFY SAME POSITION AS STONE FND. BY GENESEE CO. ROAD COMM.; FND ROD FITS GLO JOG AND IS ONLY 3.5' W. OF PRORATED 1888 TESKEY POSITION (VS. 10' +/- FOR 1959 BLACK) DUE TO LACK OF SUBSTANTIATING MEASUREMENTS FOR 1959 BLACK STONE AND SINCE THE FND ROD HAS BEEN USED AND ACCEPTED SINCE PRIOR TO 1971 I REJECT 1959 BLACK POSITION IN FAVOR OF FND ROD IN MON. BOX

ACCEPTED 1/2" ROD AS BEST EVIDENCE OF ORIGINAL CORNER LOCATION

SEE ALSO BACK OF THIS FORM

C. Description of monument for corner and accessories established to perpetuate locating the position of the corner:

K-13 REMOVED ROD, SET STANDARD MONUMENT (5/8" ROD W/ BRASS CAP IN CONC, IN MON BOX)

N44°E, 49.59' CENTER OF ROAD SIGN POST  
N68°E, 43.12' S. EDGE OF STOP SIGN POST  
S40°E, 39.72' TOP CENTER OF PHONE RISER  
S33°E, 41.10' TOP CENTER OF CONC R/W MARKER POST  
S56°W, 82.79' E. EDGE OF CONC PROJECT MARKER POST  
S73°W, 79.84' TOP CENTER OF PHONE RISER  
N75°W, 88.69' FND P-K NAIL W/FLAG. E. FACE 28" OAK  
N45°W, 130.20' SE COR. CONC. BLOCK FOUNDATION OF HOUSE #1500  
N30°E, 65.59' TOP CENTER OF PHONE RISER  
WEST, 43.82' FND POINTED STONE IN MON BOX


Signed by Jonathan M. Field  
Surveyor's Michigan License No. 37276

Date 10-27-93

APPROVED  
10-27-93

FORM APPROVED BY MICHIGAN STATE BOARD OF LAND SURVEYORS, JAN. 28, 1971  
REVISED MAY 14, 1975  
REVISED JAN. 1983  
ADAPTED FOR WORD PROCESSING MARCH, 1993

COPY

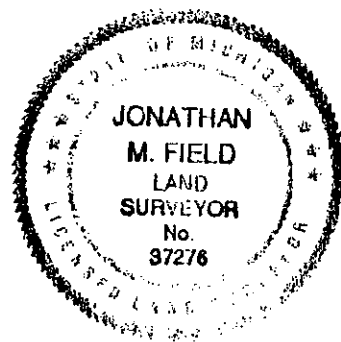

SECTION A (CONT.)

1989 ROWE ENG. - SZYSZKOSKI, P.S. #33986, SURVEY L.2380, PG.304-307 (GENESEE CO.) - FND 1/2" IRON IN MON BOX  
 N85W 88.76' TAG #32332 28" OAK, WEST 43.86' STONE IN MON BOX, SW 79.92' PHONE RISER, SE 41.10' R/W POST  
 1989 SZYSZKOSKI, P.S. #33986; LCRC PG.75 - FND 1/2" ROD IN MON BOX w/ROTTED WOOD HUB, SAME WITS AS 1989 REI  
 SURVEY CITED ABOVE

COPY



SECTION 36

T10N-R7E

L-13

1821 GLO 2640'  
 1888 TESKEY 2627.46'  
 1989 REI 2633.32'  
 1993 REI 2633.12'

K-13

1821 GLO 2640'  
 1888 TESKEY 2629.44'  
 1993 REI 2628.18'

SECTION 35

T10N-R7E

J-13

SECTION 1

T9N-R7E

1821 GLO 43.56'  
 1971 REI 43.80'  
 1988 DUNTON 44'+/-  
 1988 CORNERSTONE 43.86'  
 1989 REI 43.86'  
 1993 REI 43.82'

K-1  
 (APPARENT)

FND STONE IN  
 MON BOX  
 1.31' S

SECTION 2

T9N-R7E