

1993
COMMISSION
1993 REMONUMENTATION PROGRAM
LAND CORNER RECORDATION CERTIFICATE
Filing Requirement of Act 74, Mich. P.A. 1970

For corners in
TUSCOLA
(County)

Located In: MILLINGTON TOWNSHIP
Corner Code #

1. Public Land Survey T 10 N R 8 E A-13
T R
T R
T R
T R

2. Property Controlling S T R
in Section S T R
3. Miscellaneous S T R
Property in Sec. S T R

4. Lot No. , Recorded Plat
5. Private Claims

RECEIVED FOR RECORD
LIBER NO. PAGE NO. 10
FILING NO. Millington
93 NOV 19 PM 1:25
VIRGINIA K. HARRIS
TUSCOLA COUNTY
REGISTER OF DEEDS
Register of Deeds Stamp & File Number

I, JONATHAN M. FIELD, in a field survey on OCTOBER 19 93, do hereby certify that under requirements of P.A. 74, Michigan P.A. of 1970, the corner points mentioned in lines 1 and 2 above were in conformance with regulations and rules therefore as required in the current manual of survey instructions of the United States Department of the Interior, Bureau of Land Management or by a decree of a Court of Law and/or that the corner points mentioned in lines 3, 4 and 5 above were in conformance with the rules of the Michigan Board of Land Surveyors or by a Decree of a Court of Law; established, re-established, monumented, re-monumented, recovered, found as expressed below:

NOTE: Not more than 4 corners, all in the same town and range, may be recorded on this certificate.

A. Description of original monument and accessories and/or subsequent restoration:


1821 GLO - WAMPLER, D.S.; SET POST; MAPLE 7" S45E 6LKS., BEECH 8" S4W (NO DIST.)
1888 TESKEY, C.S.; NO OBJECT STATED; MAPLE 7" N16W 2LKS., B.OAK 4" S15 1/2E 160LKS.
1891 FELTON, C.S.; NO OBJECT STATED - FROM B.T.'S IN 1878; PINE 36" N73E 88 LKS., PINE 24" N51W 89 1/2 LKS
1959 BLACK, P.S.#3384; TUSCOLA CO. RD. COMM. WIT CARD - FND POINTED ONYX STONE, SET 5/8" ROD; S40E 49.61' SPIKE 36" MAPLE, S15E 104.00' SPIKE 36" OAK, N45W 123.33' SE COR. HSE., N25E 47.75' T.POLE
1976 BECK, P.S.#21559; LCRC PG.42 - FND 1/2" ROD; S45E 49.98' NAIL W/DISC 40" MAPLE, N45E 46.91' TAG #11192 T.POLE, N70W 96.22' NAIL W/DISC 30" MAPLE
1983 TUSCOLA CO. RD. COMM. - DUNTON, P.S.#23503; FIELD NOTES JOB NO. LR-5437 - FND 5/8" ROD; NO WITS GIVEN
1988 DUNTON LAND SURVEY. - DUNTON, P.S.#23503; FIELD NOTE JOB NO. 822-87 - FND 1/2" ROD; NO WITS GIVEN
1989 SZYSZKOSKI, P.S.#33986; LCRC PG.75 - FND 5/8" ROD; N45E 42.40' RD SIGN, NW 47.34' NAIL W/FLAG. 30" BOXELDER, NW 97.65' NAIL W/FLAG. 28" MAPLE, N45E 46.75' NAIL W/TAG #11192 CUT-OFF T.POLE

B. Description of corner evidence found and/or method applied in restoring or reestablishing corner:

1993 ROWE ENG. - FIELD, P.S. #37276; FND 5/8" ROD; 2'E & 3'N TO C/L INTERSECTION OF GRAV. ROADS N-S-E-W
2 PREVIOUS WITS INDICATE THAT IT IS IN THE SAME POSITION AS 1959 BLACK

ACCEPTED 5/8" ROD AS BEST EVIDENCE OF ORIGINAL CORNER LOCATION

COPY

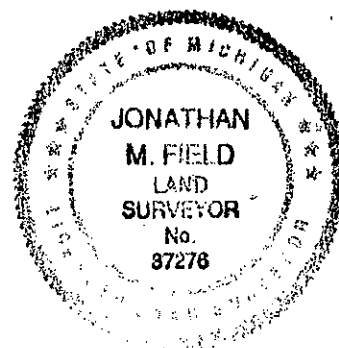

SEE ALSO BACK OF THIS FORM

C. Description of monument for corner and accessories established to perpetuate locating the position of the corner:

A-13 REMOVED ROD, SET STANDARD MONUMENT (5/8"X36" ROD W/ BRASS CAP IN CONC)
N38°W, 45.88' FND 40D NAIL W/TAG #20709 IN SE ROOT 30" BOXELDER
N74°W, 95.98' SET NAIL W/REMON TAG IN SE ROOT 28" MAPLE
S42°W, 49.07' ROAD SIGN POST
S26°E, 81.91' SET NAIL W/REMON TAG ABOVE FND NAIL W/DISC IN SW FACE P.POLE
N45°E, 46.75' FND P-K NAIL W/TAG #20709 IN SE FACE CUT-OFF T.POLE (ALSO FND NAIL W/TAG #11192 AND NAIL W/DELTA ENG. TAG IN NW FACE)
N45°E, 42.40' ROAD SIGN POST
N45°W, 123.44' SE COR. NEW CONC. BLOCK BASEMENT UNDER OLDER HOUSE

Signed by Jonathan M. Field Date 10-29-93

Surveyor's Michigan License No. 37276

APPROVED
10-27-93

100
J.M.F.

COPY



SECTION 31
T10N-R8E

1821 GLO 3537.60'
1891 FELTON 3467.64'
1993 REI 3471.61'

SECTION 6
T9N-R8E

SECTION 36
T10N-R7E

1821 GLO 2640'
1888 TESKEY 2627.46'
1988 DUNTON 2631.76'
1993 REI 2630.28'

SECTION 1
T9N-R7E

B-13

A-13

L-13

COMMON CORNER
NO JOG