

1993

COMMISSION

1993 REMONUMENTATION PROGRAM
LAND CORNER RECORDATION CERTIFICATEFiling Requirement of Act 74, Mich. P.A. 1970
MILLINGTON TOWNSHIPFor corners in
TUSCOLA
(County)

Located In:

Corner Code #

1. Public Land Survey T 10 N R 8 E
T R
T R
T R
2. Property Controlling S T R
in Section S T R
3. Miscellaneous S T R
Property in Sec. S T R

B-13

4. Lot No. _____, Recorded Plat _____
5. Private Claims _____

I, JONATHAN M. FIELD, in a field survey on OCTOBER 19 93, do hereby certify that under requirements of P.A. 74, Michigan P.A. of 1970, the corner points mentioned in lines 1 and 2 above were in conformance with regulations and rules therefore as required in the current manual of survey instructions of the United States Department of the Interior, Bureau of Land Management or by a decree of a Court of Law and/or that the corner points mentioned in lines 3, 4 and 5 above were in conformance with the rules of the Michigan Board of Land Surveyors or by a Decree of a Court of Law, established, re-established, monumented, re-monumented, recovered, found as expressed below:

NOTE: Not more than 4 corners, all in the same town and range, may be recorded on this certificate.

A. Description of original monument and accessories and/or subsequent restoration:

- 1821 GLO - WAMPLER, D.S.; SET 1/2 MILE POST; BIRCH 10" S60E 13LKS., CHERRY 8" N80W 23LKS.
1891 FELTON, C.S.; NO OBJECT STATED - FROM B.T.'S IN 1878; SUGAR 3" S45W 52 1/2LKS., MAPLE 3" N27 1/2 W 28LKS.
1975 KRAFT ENG. - KRAFT, P.S.#14093; TUSCOLA CO. RD. COMM. WIT CARD (DATED OCT.1975) - SET T-IRON; NE 55.42' P.POLE, SW 32.76' 30" MAPLE, NW 42.65' 36" MAPLE
1976 BECK, P.S.#21559; LCRC PG.42 (FIELD DATE JAN.1975) - FND T-IRON; S25W 32.76' NAIL W/DISC 30" MAPLE, S50E 120.12' TAG #11192 P.POLE, N45W 42.61' NAIL W/DISC 30" STUMP
1982 CHMP - MILLER, P.S.#12024; UNRECORDED SURVEY JOB NO. 26205 - FND T-IRON; SAME WITS AS 1976 BECK LCRC
1984 TUSCOLA CO. RD. COMM. - DUNTON, P.S.#23503; FIELD NOTES JOB NO. LR-5563 - FND T-IRON; DIST 344' +/- TO B-1 T9N-R8E
1991 ROWE ENG. - SZYSZKOSKI, P.S.#33134; WIT CARD - SET 1/2" ROD W/CAP #33134; N45E 48.46' RD SIGN POST, N45W 47.07' ROD W/CAP #33134, S50W 23.12' ROD W/CAP #33134, S50E 122.09' TAG #11192 P.POLE

B. Description of corner evidence found and/or method applied in restoring or reestablishing corner:

- 1993 ROWE ENG. - FIELD, P.S.#37276; FND 1/2" ROD W/WORN YELLOW PLASTIC CAP, 1.5'S. TO C/L INTERSECTION OF GRAV. RD. N. & ASPH. RD. E-W; FND NO OTHER EVIDENCE

ACCEPTED 1/2" ROD W/CAP AS BEST EVIDENCE OF ORIGINAL CORNER LOCATION

	A	B	C	D	E	F	G	H	I	J	K	L	M
1													
2	6		5		4		3		2		1		
3													
4	7		8		9		10		11		12		
5													
6	18		17		16		15		14		13		
7													
8	19		20		21		22		23		24		
9													
10	30		29		28		27		26		25		
11													
12	31		32		33		34		35		36		
13													

RECEIVED FOR RECORD
LIBER NO. _____ PAGE NO. 21
FILED IN Millington
93 NOV 19 PM 1:25
VIRGINIA A. MCGEE
TUSCOLA COUNTY
REGISTER OF DEEDS

Register of Deeds Stamp & File Number

COPY

SEE ALSO BACK OF THIS FORM


C. Description of monument for corner and accessories established to perpetuate locating the position of the corner:

B-13 REMOVED ROD, SET STANDARD MONUMENT (5/8" ROD W/ BRASS CAP IN CONC, IN MON. BOX)

- N37°E, 48.46' ROAD SIGN POST
S52°E, 122.09' SET NAIL W/REMON TAG BELOW FND NAIL W/TAG #11192 IN SW FACE P.POLE (OLD CUT-OFF P.POLE AT 120.8' SE)
N42°E, 46.04' TOP CENTER OF PHONE RISER
S10°W, 15.04' W. EDGE OF W. POST OF DIRECTIONAL SIGN
N45°W, 47.07' FND 1/2" ROD W/CAP #33134
S50°W, 23.12' FND 1/2" ROD W/CAP #33134
WEST, 342.51' FND T-IRON

Signed by Jonathan M. Field
Surveyor's Michigan License No. 37276

Date 10-27-93

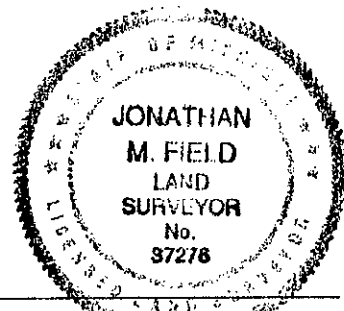


FORM APPROVED BY MICHIGAN STATE BOARD OF LAND SURVEYORS, JAN. 28, 1971
REVISED MAY 14, 1975
REVISED JAN., 1983
ADAPTED FOR WORD PROCESSING MARCH, 1993


APPROVED
10-25-93

7500
J.P.E.

COPY

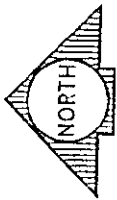

SECTION 31
TION-R8E

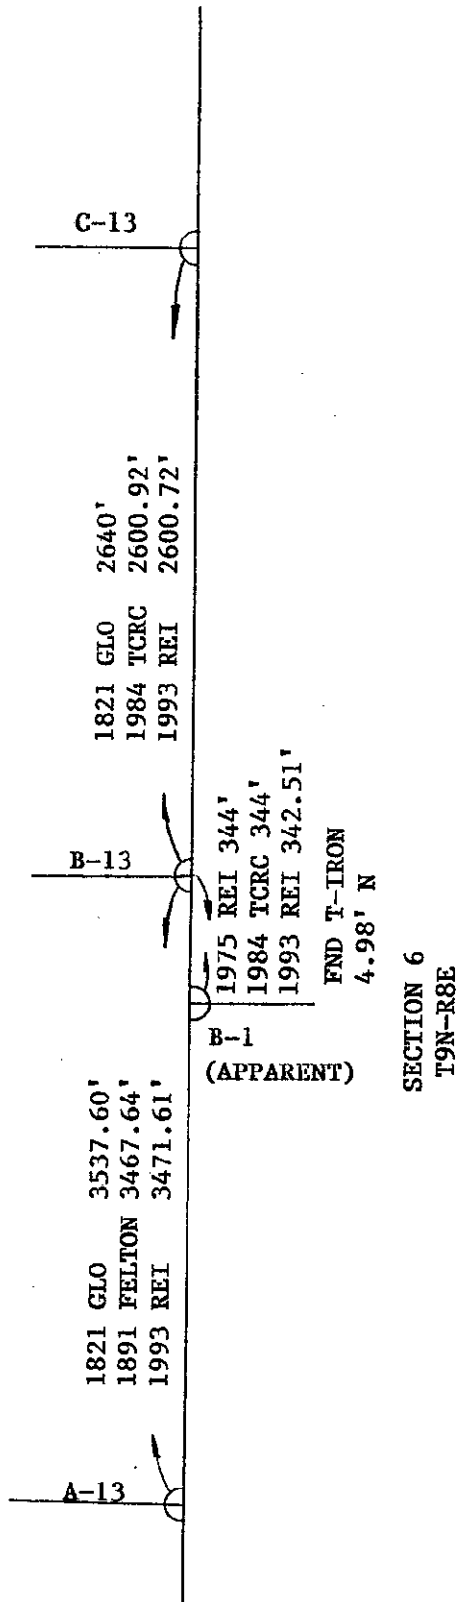

SECTION 6
T9N-R8E