SURVEY & REMONUMENTATION

APR 2 5 1995

COMMISSION

1994 REMONUMENTATION PROGRAM

LAND CORNER RECORDATION CERTIFICATE

	•						
Filing	Requirement	of	Act	74,	Mich.	P.A.	1970

For corners in Vassar Tow	nship	······································		
Tuscola	_ Located In:	Corner Code ##	STE	ENED ER NO ING NO. V PSSS.
(County)			DAX	7 - 4 -
Public Land Survey	T11N_R8E	G-13	^무 C크	FOR RECORD PAGE NO. # 95 AR TWP. PM 4: 25
1. I ubite Land Odivey	T R			12 A S A R
	T R			RECORD PAGE HO 95 TWP 1 4: 25
			S , C.	23.50 H H
2. Property Controlling	S R			
in Section	S T R			! !
3. Miscellaneous	S R		Register of Deeds Star	np & File Number
Property in Sec.	S R			
_				
4. Lot No, Rec	corded Plat		ABCDE	FGHIJKL
5. Private Claims			2 6 5	4 3 2
			3	
			4 7 8	9 10 11 12
Kenneth D. Dunton	in a field survey on	0ct. 15 19 94		
do hereby certify that under requi	rements of P.A. 74, Michigan P.A.	of 1970, the corner points mentic	oned 6 1 17 1	6-15-14-13-
in lines 1 and 2 above were in courrent manual of survey instruct	conformance with regulations an	d rules therefore as required in	and 7	
Management or by a decree of a C	ourt of Law and/or that the corne	r points mentioned in lines 3, 4 a	and 5 8 19 20	21 22 23 24
above were in conformance with:	the rules of the Michigan Board o	if Land Surveyors or by a Decree	eofa olli	
Court of Law; established, re- expressed below:	established, monumented, re-r	nonumented, recovered, found	0 as	28 27 26 25
NOTE: Not more than 4 cor	nore all in the same town ar	nd range may be recorded	11	
on this certificate.	liers, an in the same town or	id fallys, may so loos so	12 31 32 3	333536-
on this certainate.			13	
A. Description of original mo	onument and accessories and	d/or subsequent restoration:	•	
	1 - 00 700	2	mudi 1000	
1821 G.L.O. Notes	June 29, 189		upril 1898 Edward Teskey, survey	ior.
Set post cor. Sec. 3	G. B. Felton	, surveyor E	istake previously es	
Dino 5 N QA F 15	Post & crock		lo accessories noted.	
Pine 9 S 47 W 12				
		•		
Section A continued	on back of this form			
B. Description of corner evid			ablishing corner:	
	т		_	t
Found 1/2" x 18" iron	rod over 1 1/4" x 2	4" pipe.		
Accepted 1/2" rod & 1	1/4" pipe as the pro	oper position of the	e original corner.	
				Šr.
•				
				•
•				
C. Description of monument	for corner and accessories	established to perpetuate lo	cating the position of the co	rner:
Removed 1/2" rod & 1	1/4" pipe and place	d 36" concrete monum	ent with standard br	ass cap
stamped corner G-13,				
Placed monument box	over monument.	22510		
N42°43'30"E 45.03' T N53°52'E 55.62' fnd.	nd, 1/2" rod & cap #	2331U. nole – set T (Re	emon tag & spike abo	ive.
COE OUT EE OO Find	spikes & bottle cap	s in SF & NW face of	p. pole - set T. G	Remon tag
& spike above nail	in NW face.		u heart Car	E OF MICHAEL STATE
S50°39'10"W 79.29' f	nd. 1/2" rod & cap #	37276.	# 65°/	The state of the s
S89°42'W 110.79' fnd	.]" iron bar at app	arent Cor. G-1, T10N	I-R8E.	ENNETH D. Y. L. DURWON AND
			121	DOMESTIN A TOTAL
1	NIX		Navambar 27 Bank	summatoR ∫ ∰ }
Signed by	-XY///	Date	November 21,1994	No. 23503
Surveyor's Michigan License		PROVED SALE.	FORM APPROVED BY MICHIGAN STATE BOAR	الوالمؤري للمسته
Surveyor's iviichigan Eidense	//-	OWE -1-	LOUIS WILLIAMS OF WINDWARD OF ALL STATES	PREVISED MAY 14, 19
		J 11 . // //		

Sept. 10, 1975 Land Cor. Rec. Cert. filed on Page 28, Vassar Twp., by James A. Beck, L.S. #21559.

Fnd. 1" iron 1' deep.

N20°W 55.70' to t.p. N45°E 54.90' to p.k. nail in p.p.

N60°W 68.55' to sign post.

\$30"W 55.97' nail & washer E. face.

Sept. 11, 1975 Survey by James A. Beck, L.S. #21559, with Rowe Engineering Inc., recorded in Liber 474 on Pages 250 & 251, Tuscola County records. Object and accessories same as L.C.R.C. filed on Page 28, Vassar Twp.

Oct. 30, 1975 Land Cor. Rec. Cert. filed on Page 34, Vassar Twp., by James A. Beck, L.S. #215! Fnd. 5/8" iron rod. Accessories same as L.C.R.C. Page 28, Vassar Twp. & Survey, Liber 474 on Pages 250 & 251, except accessory S30°W 55.97' was identified as nail & washer in E. face of p.p.

Dec. 28, 1989 Unrecorded survey and mortgage report by B. D. Ferguson, L.L.S. #26454, with R. C. Eng. Inc. Part of SE 1/4 Sec. 33, T11N-R8E. SE corner. 1" pipe.

fce. pwr. pole. N20°W 55.70'


N60°W 68.55' fce. sign post.

S30°W 55.97' nail & washer E. face.

N45°E 54.90' p.k. nail in pwr. pole.

Oct. 27, 1990 Survey by Kenneth D. Dunton, L.S. #23503, recorded in Liber 608 on Page 1145 & 1146, Tuscola County records. Found iron rod in place. Field notes indicate fnd. pipe & raised with 1/2" rod.

West 110.8' NW cor. Sec. 3, T10N-R8E. S60°E 55.0' spike in SW face p. pole. S30°W 55.8' nail & cap in SW face p. pole. N40°W 73.3' tele. ped.

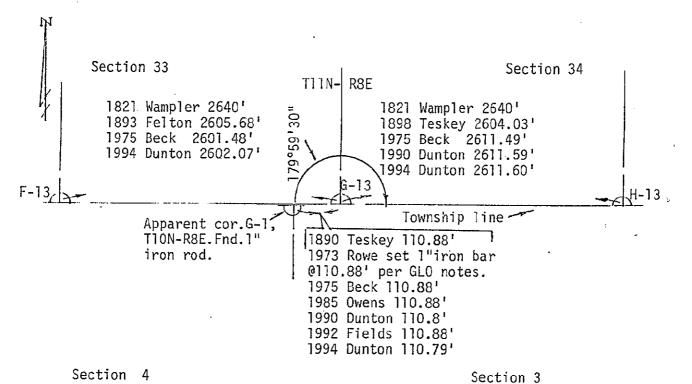

TION-R8E