

COPY

1999 REMONUMENTATION PROGRAM

LAND CORNER RECORDATION CERTIFICATE  
Filing Requirement of Act 74, Mich. P.A. 1970

For corners in Vassar Township

Tuscola  
(County)

Located In:

Corner Code #

1. Public Land Survey

T11N R8E

K-8

T R

T R

T R

T R

2. Property Controlling  
in Section

S

T R

S

T R

3. Miscellaneous  
Property in Sec.

S

T R

S

T R

4. Lot No. , Recorded Plat

5. Private Claims

Lionel Roy Emery

I, P.S. #24593, in a field survey on July 21 19 99 do hereby state that under requirements of P.A. 74, Michigan P.A. of 1970, the corner points mentioned in lines 1 and 2 above were in conformance with regulations and rules therefore as required in the current manual of survey instructions of the United States Department of the Interior, Bureau of Land Management or by a decree of a Court of Law and/or that the corner points mentioned in lines 3, 4 and 5 above were in conformance with the rules of the Michigan Board of Land Surveyors or by a Decree of a Court of Law; established, re-established, monumented, recovered, found as expressed below:

NOTE: Not more than 2 corners, all in the same town and range, may be recorded on this certificate.

|    | A  | B | C  | D | E  | F | G  | H | I  | J | K  | L | M |
|----|----|---|----|---|----|---|----|---|----|---|----|---|---|
| 1  |    |   |    |   |    |   |    |   |    |   |    |   |   |
| 2  | 6  |   | 5  |   | 4  |   | 3  |   | 2  |   | 1  |   |   |
| 3  |    |   |    |   |    |   |    |   |    |   |    |   |   |
| 4  | 7  |   | 8  |   | 9  |   | 10 |   | 11 |   | 12 |   |   |
| 5  |    |   |    |   |    |   |    |   |    |   |    |   |   |
| 6  | 18 |   | 17 |   | 16 |   | 15 |   | 14 |   | 13 |   |   |
| 7  |    |   |    |   |    |   |    |   |    |   |    |   |   |
| 8  | 19 |   | 20 |   | 21 |   | 22 |   | 23 |   | 24 |   |   |
| 9  |    |   |    |   |    |   |    |   |    |   |    |   |   |
| 10 | 30 |   | 29 |   | 28 |   | 27 |   | 26 |   | 25 |   |   |
| 11 |    |   |    |   |    |   |    |   |    |   |    |   |   |
| 12 | 31 |   | 32 |   | 33 |   | 34 |   | 35 |   | 36 |   |   |
| 13 |    |   |    |   |    |   |    |   |    |   |    |   |   |

A. Description of original monument and accessories and/or subsequent restoration:

June, 1822 G.L.O. Notes, Joseph Fletcher, D.S. Set 1/4 section post, W. Cedar 12" S27°E 9 links, B. Ash 12" S40°W 21 links. July 3, 1896 Survey of Section 23 by Edward L. Teskey, County Surveyor, set proportionate distance between section corners, perpetuated by stake, no accessories given. April 8, 1898 Survey of Sec. 24 by G. B. Felton, County Surveyor, previously set by Teskey, C.P. & crockery at corner, no accessories given. July 20, 1971 Survey L-1, P-530 & 531 by David T. Rowe, P.S. #11192, no mention of object found or set, N30°W 218.0' P. Pole, S30°W 165.35' P. Pole, East 38.20' fence post.

Sec. A con't on back of form.

B. Description of corner evidence found and/or method applied in restoring or reestablishing corner:

Found "T" iron in monument box and accepted same as the best evidence of the original corner position.

C. Description of monument for corner and accessories established to perpetuate locating the position of the corner:

Removed "T" iron and perpetuated with 5/8" iron rod & standard brass cap stamped K-8, T11N-R8E. Encased rod & cap in concrete in monument box.  
N50°E 60.65' set remon. tag in SE face 10" White Birch.  
N85°E 61.48' set remon. tag in South face 12" Ash.  
S25°E 26.32' set 1/2" iron rod in road shoulder.  
West 71.71' set remon. tag in South face P. Pole.

Due to the untimely illness of Mr. Emery, I, Kenneth D. Dunton, P.S. #23503, have reviewed Mr. Emery's field notes and have prepared this form.

Signed by

Date


Surveyor's Michigan License No. 23503

APPROVED

12-13-99

KML  
RLB  
Jmg

FORM APPROVED BY MICHIGAN STATE BOARD OF PROFESSIONAL SURVEYORS, JAN. 28, 1971  
REVISED MAY 14, 1975  
REVISED JAN., 1983  
REVISED OCT., 1995

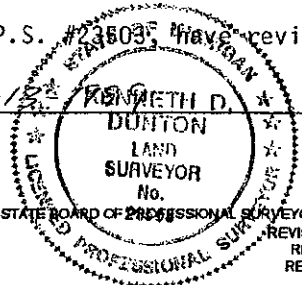

# COPY

## Section A Con't.

Feb., 1973 L.C.R.C. Page 20, by David T. Rowe, P.S. #11192, set P.K. nail in centerline 21' asphalt pavement on East and West fence line, N30°W 218.0' nail & tag in P. Pole, S30°W 165.35' nail and tag in P. Pole, East 38.20' fence post. Jan. 4, 1974 Survey L-438, P-791 & 792 by David T. Rowe, P.S. #11192, no mention of object found or set or accessories. April 4, 1991 Survey L-616, P-1416 by B. D. Ferguson, P.S. #26454, "T" iron in monument box, S30°E 82.30' center top riser box, West 71.20' nail & tag in N. face P. Pole, N30°E 136.77' SE corner at base of riser box, N50°E 60.40' W. face 8" Birch. May 2, 1995 Survey L-681, P-1407 & 1408 by Earl E. Gravlin, P.S. #23510, found "T" bar in monument box, West 71.70' S/S Power Pole, N40°E 60.72' S/S 8" Birch, S15°W 130.10' 48" CMP.

