

SURVEY &
REMONUMENTATION

DEC 02 1993

COMMISSION

1993 REMONUMENTATION PROGRAM
LAND CORNER RECORDATION CERTIFICATE
Filing Requirement of Act 74, Mich. P.A. 1970

For corners in

TUSCOLA
(County)

Located In:

VASSAR TOWNSHIP
Corner Code ##

1. Public Land Survey T 11N R 8E M-12
T _____ R _____
T _____ R _____
T _____ R _____
2. Property Controlling S _____ T _____ R _____
in Section S _____ T _____ R _____
3. Miscellaneous S _____ T _____ R _____
Property in Sec. S _____ T _____ R _____

4. Lot No. _____, Recorded Plat _____
5. Private Claims _____

RECEIVED FOR RECORD
VASSAR TWP
LIBER NO. _____ PAGE NO. _____
FILING NO. #79
93 OCT 22 PM 2:42
VIRGINIA M. McLAUREN
TUSCOLA COUNTY
REGISTER OF DEEDS

Register of Deeds Stamp & File Number

I, Kenneth D. Dunton, in a field survey on July 18, 19 93, do hereby certify that under requirements of P.A. 74, Michigan P.A. of 1970, the corner points mentioned in lines 1 and 2 above were in conformance with regulations and rules therefore as required in the current manual of survey instructions of the United States Department of the Interior, Bureau of Land Management or by a decree of a Court of Law and/or that the corner points mentioned in lines 3, 4 and 5 above were in conformance with the rules of the Michigan Board of Land Surveyors or by a Decree of a Court of Law; established, re-established, monumented, re-monumented, recovered, found as expressed below:

NOTE: Not more than 4 corners, all in the same town and range, may be recorded on this certificate.

A. Description of original monument and accessories and/or subsequent restoration:

1821 G.L.O. Notes Sept. 18, 1975
Joseph Wampler, D.S. Survey Liber 453-Page 486
Set 1/2 M. Post by James A. Beck, RLS# 21559
Elm 9" S38°W 9.24' No statement of object found
Hemlock 4" S36°E 14.52' or set.
No accessories.

May 6, 1976 Act 74 Vassar Twp. Pg
Arthur H. Leach, RLS# 7236
Found rod & cap # 11192 (D.T. Rowe
N10°E38.45' to E. bridge rail pipe
N50°W34.28' to W. bridge rail pipe
S40°E41.15' to spike in SW side
triple Balsam

NOTE: Section A. continued on back of form.

B. Description of corner evidence found and/or method applied in restoring or reestablishing corner:

and accepted
Found 5/8" rod in 3/4" pipe with 1/2" rod below 5/8" rod.

Also found remains of two previous accessories whose condition warrant they no longer be used.
S40°E 41'± Remains of triple stump lying on ground.
N60°E 63'± Remains of 12" rotted stump.

C. Description of monument for corner and accessories established to perpetuate locating the position of the corner:

Set 4"X36" concrete monument with 36"X 5/8" rod through center and 2" Standard brass cap stamped Corner M-12, T11N-R8E.
N61°55'W 36.01' Set T.C. Re-mon tag and spike in NE face 6" Elm tree
N20°15'W 46.03' Found "+" chisled atop West end C.S.P. pipe arch (Note: CSP identified as 60" is
N25°36'E 50.98' Found "+" chisled atop East end C.S.P. pipe arch (actually 38.5' of 78"X53"C.S.
N89°46'E 33.00' Set 1/2"X18" rod & cap #23503

Signed by

Kenneth D. Dunton

Date

September 20, 1993


Surveyor's Michigan License No. 23503

APPROVED

SEPT. 20, 1993

Q.M.A. 1100

FORM APPROVED BY MICHIGAN STATE BOARD OF LAND SURVEYORS, JAN. 29, 1971

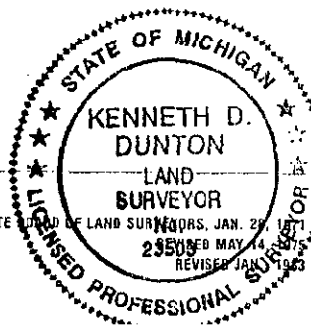

Sept 25, 1978 Act 74, Vassar Township 11-8 Page 53 by David T. Rowe, RLS# 11192
Found 3/8"rod 12" deep, raised with 3/4"pipe.
S40°E 40.96' Spike in 24" Butternut
N30°E 50.97" "+" on top center 60" CMP
N20°W 46.03' "+" on top center 60" CMP
Note: Additional accessories from
on file at Rowe Engineering, Can
N60°E 63.00' RLS11192 tag 12" But

Also, R.C. Woloshen found 3/4" pipe at this location per witness card at Rowe Eng., Caro MI.

Copy

