

1996 REMONUMENTATION PROGRAM
LAND CORNER RECORDATION CERTIFICATE
Filing Requirement of Act 74, Mich. P.A. 1970

For corners in Fremont Township

Tuscola (County)	Located In:	Corner Code #
1. Public Land Survey	T11N R 9E T R T11N R10E T R	M-8 ✓ A-8
2. Property Controlling in Section	S T R S T R	
3. Miscellaneous Property in Sec.	S T R S T R	
4. Lot No. _____, Recorded Plat _____		
5. Private Claims _____		

RECEIVED FOR RECORD
LIBER NO. _____ PAGE NO. _____
FILE NO. Fremont
55 DEC 10 PM 4:4
TUSCOLA COUNTY
REGISTER OF DEEDS
Register of Deeds Stamp & File Number

I, Kenneth D. Dunton in a field survey on April 21, 19 96,
do hereby certify that under requirements of P.A. 74, Michigan P.A. of 1970, the corner points mentioned
in lines 1 and 2 above were in conformance with regulations and rules therefore as required in the
current manual of survey instructions of the United States Department of the Interior, Bureau of Land
Management or by a decree of a Court of Law and/or that the corner points mentioned in lines 3, 4 and 5
above were in conformance with the rules of the Michigan Board of Land Surveyors or by a Decree of a
Court of Law; established, re-established, monumented, re-monumented, recovered, found as
expressed below:

NOTE: Not more than 4 corners, all in the same town and range, may be recorded
on this certificate.

	A	B	C	D	E	F	G	H	I	J	K	L	M
2	6	5	4	3	2	1							
3													
4	7	8	9	10	11	12							
5													
6	18	17	16	15	14	13							
7													
8	19	20	21	22	23	24							
9													
10	30	29	28	27	26	25							
11													
12	31	32	33	34	35	36							
13													

A. Description of original monument and accessories and/or subsequent restoration:

G.I.O. 1834	June 22, 1979
Harvey Parke, D.S.	L.C.R.C. form filed by James L. Quist, R.L.S. #25868 on
Set Quarter Section Post	Page 42, T11N-R10E.
Hemlock 9 S35W 21 1/2	Set 1/2" re-rod #11192 by single proportionate meas. between
W. Ash 6 N 32 1/2 W 23	NW & SW cor. Sec. 19, occupational lines match.
	S50°W 35.38' RLS #11192 tag 6" Oak
	S45°E 40.25' RLS #11192 tag 24" Maple
	N30°E 86.17' center 2" Maple
	West 4' + centerline gravel road N-S

B. Description of corner evidence found and/or method applied in restoring or reestablishing corner:

Found 1/2" rod & cap #25868, 5' + W. of N-S gravel centerline (iron is 0.25 W. & 0.11 S. of
single proportion position). Held position of iron found as the best evidence of the original
corner.

C. Description of monument for corner and accessories established to perpetuate locating the position of the corner:


Set standard monument stamped M-8, T11N-R9E.
S46°W 23.10' set remon. tag & spike in SE root of twin 15" oaks.
S49°W 35.73' chiseled notch atop W. end of 40' of 30" CSP.
S47°E 30.83' chiseled notch atop E. end of 40' of 30" CSP.
S45°E 40.28' fnd. #11192 tag & spike in SW face 22' maple.

Note: This corner is common with A-8, T11N-R10E.

Signed by [Signature] Date 10-30-96
Surveyor's Michigan License No. 23503

APPROVED

10-30-96

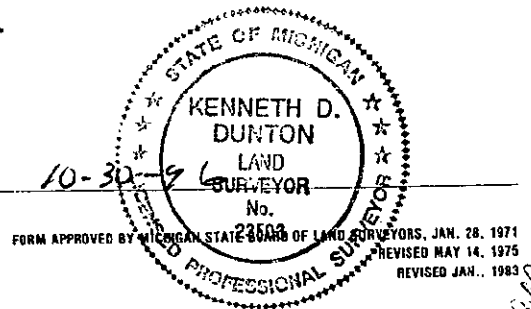

MAY 20 1997

COMMISSION

4

A-7

1834 GLO 2640'
1996 Dunton 2640.40'

T11N-R9E

T11N-R10E

180°00'37"

M-8

A-8

Section 24

Section 19

1834 GLO 2640'
1996 Dunton 2640.18'

Township Line

A-9