OCT 2 0 1994

COMMISSION

1994 REMONUMENTATION PROGRAM

LAND	CORNER	RECORDATION	CERTIFICATE
	~~		~=::::::::::::::::::::::::::::::::::::

For corners in DAYTON TOWNSHIP Filing Requirement of Act 74, Mich. P.A. 1970

	TUSCOLA	Located In:	Corner Code ##	11
	(County)		comer code ===	# 80 F
1.	Public Land Survey	T 11N R 10E T R T R	H-13	FOR RECU PAGE # 6/ A COUNTY OF DEED
_		T R		CORD FE NO.
2.	Property Controlling	S R		
	in Section	S T R		•
3.	Miscellaneous	S T R		Register of Deeds Stamp & File Number
	Property in Sec.	S T R		Togother of Decad Claim, a Till Mariotal
4.	Lot No ,	Recorded Plat		
5.	Private Claims			
				2 6 5 4 4 1 3 1 2 1 1
				4 7 8 9 10 11 12

I, Lionel Roy Emery , in a field survey on May 25 do hereby certify that under requirements of P.A. 74, Michigan P.A. of 1970, the corner points mentioned in lines 1 and 2 above were in conformance with regulations and rules therefore as required in the current manual of survey instructions of the United States Department of the Interior, Bureau of Land Management or by a decree of a Court of Law and/or that the corner points mentioned in lines 3, 4 and 5 above were in conformance with the rules of the Michigan Board of Land Surveyors or by a Decree of a Court of Law; established, re-established, monumented, re-monumented, recovered, found as expressed below:

NOTE: Not more than 4 corners, all in the same town and range, may be recorded on this certificate.

- A. Description of original monument and accessories and/or subsequent restoration:
- 1834 (Gov't. Land Office Notes) Harvey Parke, D.S. -set quarter Section post- Hemlock 20 N61W 29 Hemlock 14 N32E 21/2
- 1973 (Land Corner Recordation Certificate) David T. Rowe P.S. #11192 -found pieces of wire and wood; Set "T" iron in center S-65°W, 51.28' Nail & Cap in 4" Maple; N-60°W Nail & Cap in 4" Maple; North 30.5'+ E&W Fence line
- 1990 (Land Corner Recordation Certificate) Kenneth D. Dunton, P.S. #23503 -Found "T" iron-N45°E 21.35' nail in 6" Ash; N20°W 42.35 nail in 6" Maple; S85°E 99.00' nail in 8" Apple; S80°W 56.5' steel fence post
- B. Description of corner evidence found and/or method applied in restoring or reestablishing corner:

Found "T" iron and remaining accessories Accepted "T" iron as marking original corner

C. Description of monument for corner and accessories established to perpetuate locating the position of the corner:

Removed "T" iron and replaced with Standard Tuscola County Concrete Monument w/2" Brass Cap stamped H13 T11N R10E

4.0'-Fiberglass "Survey Marker" witness post North,

N50°E, 21.40'-T.C. Remon. tag above found nail in S.E. face of 6" Ash


S75°E, 98.98'-T.C. Remon. tag above found nail in N.E. face of 8" Apple


S70°W, 49.70'-Set 2"x18" reinforcing rod @ base of Steel fence post

N60°W, 33.96'-T.C. Remon. tag in N.E. face of 6" Ash

LIONEL ROY EMER AND JRVEYOR NΩ 24593 Date October 4, 1994

Surveyor's Michigan License No. 2455.

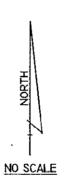

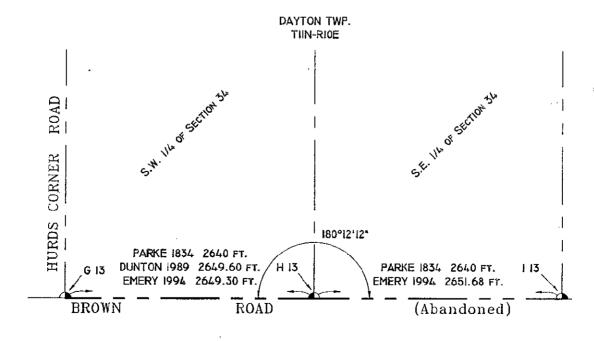

RICH TOWNSHIP LAPEER COUNTY