

Date of Survey unknown
 Edward Teskey, County Surveyor 1895-1898
 Section 7, T11N-R11E
 Cedar stake previously set.

Aug. 23, 1974


Survey by David T. Rowe, Land Surveyor #11192, Liber 443-Page 850
 No mention of object fnd. or set or accessories.
 (inaccessible in swamp)

Aug. 18, 1980

Survey by Earl E. Gravlin, Land Surveyor #23510, Liber 508-Pages 1092 & 1093.
 No mention of object found or set or accessories.
 Note: Survey indicates cor. in water.

July 22, 1993

Unrecorded survey by Earl E. Gravlin, Land Surveyor #23510, Job No. 93641.
 No mention of object found or set or accessories.

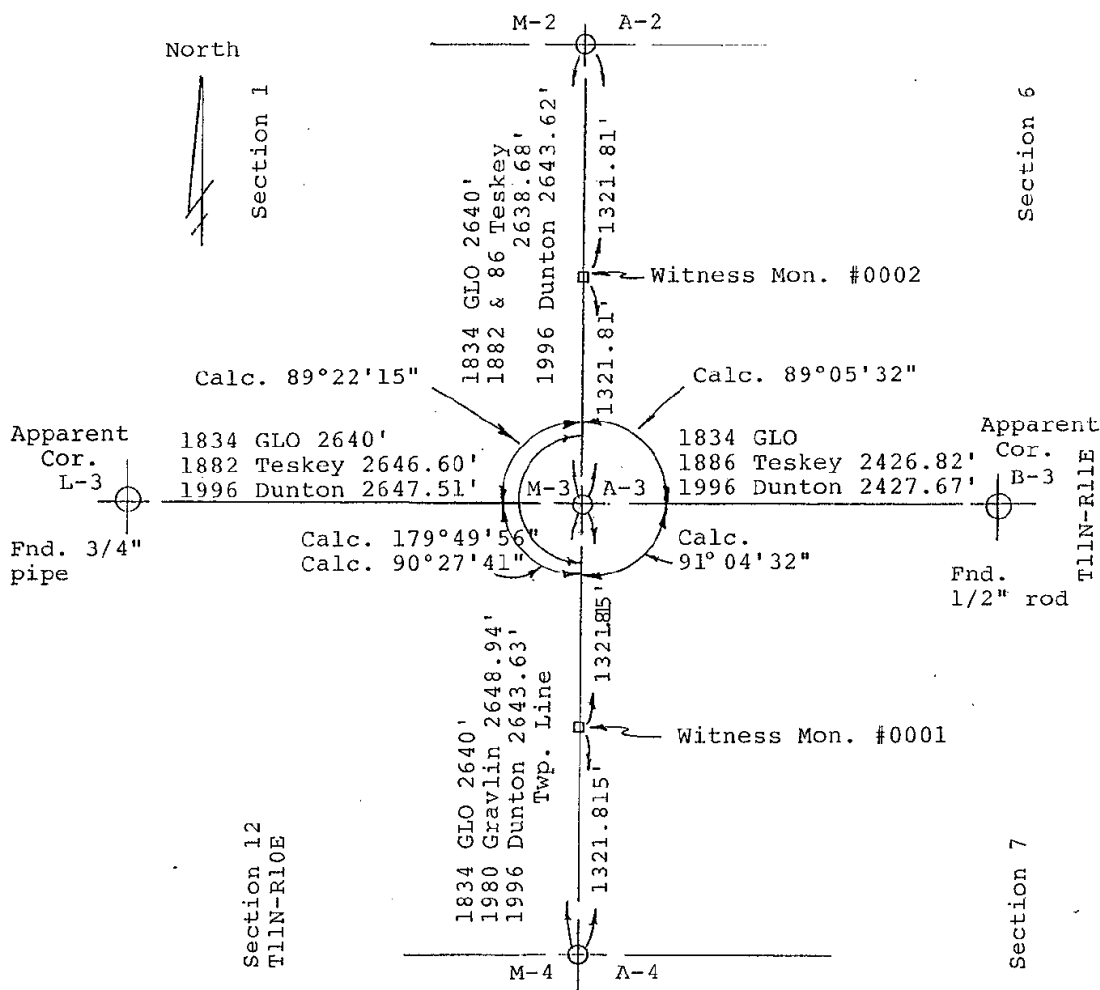

Section C continued

Witn. Mon. #0001

S83°E 71.73' set T.C. tag & spike in
 N. face 15" Maple.
 N52°20'W 4.25' fnd. 1/2" rod per
 Gravlin survey.
 West 10' set carsonite post
 S08°W 28.50' set 1/2" x 18" rod.

Wit. Mon. #0002

S70°W 21.80' set T.C. tag & spike in
 SE face 10" wood cor. post.