


Date of Survey unknown
Edward Teskey, County Surveyor 1895-1898
Section 7, T11N-R11E
Cedar stake previously set.

Aug. 23, 1974
Survey by David T. Rowe, Land Surveyor #11192, Liber 443-Page 850
No mention of object fnd. or set or accessories.
(inaccessible in swamp)

Aug. 18, 1980
Survey by Earl E. Gravlin, Land Surveyor #23510, Liber 508-Pages 1092 & 1093.
No mention of object found or set or accessories.
Note: Survey indicates cor. in water.

July 22, 1993
Unrecorded survey by Earl E. Gravlin, Land Surveyor #23510, Job No. 93641.
No mention of object found or set or accessories.

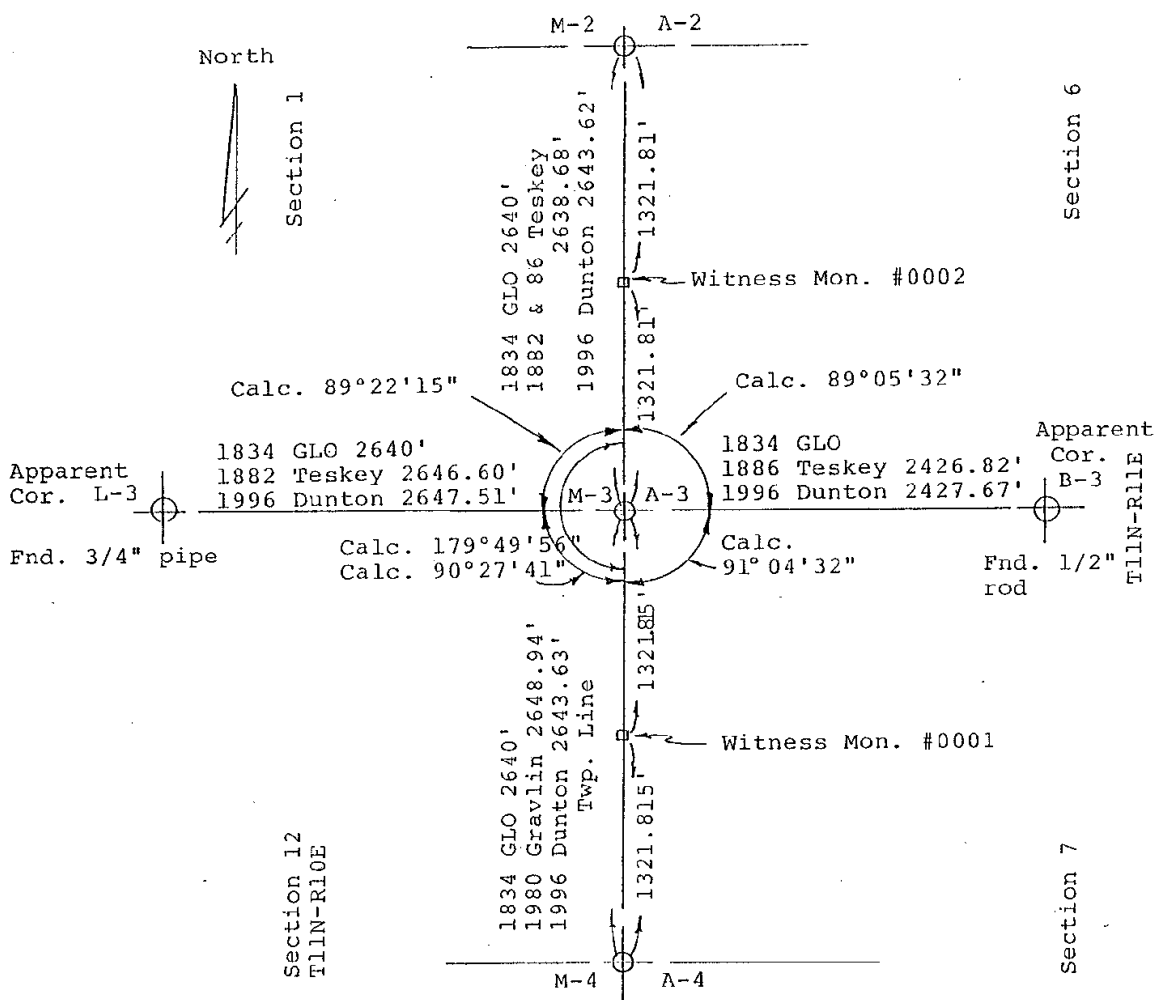

Section C continued

Witn. Mon. #0001

S83°E 71.73' set T.C. tag & spike in
N. face 15" Maple.
N52°20'W 4.25' fnd. 1/2" rod per
Gravlin survey.
West 10' set carsonite post
S08°W 28.50' set 1/2" x 18" rod.

Wit. Mon. #0002

S70°W 21.80' set T.C. tag & spike in
SE face 10" wood cor. post.