MAR 0 2 1999

____, Recorded Plat___

4. Lot No.

5. Private Claims

1998 REMONUMENTATION PROGRAM

SECTION	LAND CORNER RECORDATION CERTIFICATE Filing Requirement of Act 74, Mich. P.A. 1970
Kingston Township	, ming reading the track 14, Mich. P.M. 1910

For corners in Kingston	Township	, And the street of the street	m co / 200 600 m
Tuscola	Located In:	Corner Code #	DEC TO NO.
(County)			
1. Public Land Survey	T12N R11E T R T R T R	A-2	PAGE NO PH L: 1
Property Controlling in Section Miscellaneous Property in Sec.	S TR S T R S T R S T R		Register of Deeds Stamp & File Number

I, Kenneth D. Dunton, in a field survey on June 21, 19 98 do hereby state that under
requirements of P.A. 74, Michigan P.A. of 1970, the corner points mentioned in lines 1 and 2 above were in
conformance with regulations and rules therefore as required in the current manual of survey instructions of the
United States Department of the Interior, Bureau of Land Management or by a decree of a Court of Law and for
that the corner points mentioned in lines 3, 4 and 5 above were in conformance with the rules of the Michigan
Board of Land Surveyors or by a Decree of a Court of Law; established, re-established, monumented, recovered, found as expressed below:

NOTE: Not more than 2 corners, all in the same town and range, may be recorded on this certificate.

ı A	В	С	D	E	F	G	н	I	J	к	L ?
1	Į		Į		Ţ		- 3		Ĭ	1	
3	- 6- 	7	-5— 	Т	- 4 - 	\top	- 3 	Т	- 2 - 	T	-
. [1	T	\top	\top	1	\top	T		1	
4	-7-	+	- 8 — I	1-	- 9 I		-10-	+	-11	╁	-12
5	+	+	-	╁	╁	╁		-		╁	_
6 ├	-18	-	17—	╀	16-	- -	-1 <u>.</u> 5—	╀	-14—	-	-1 3
7	<u> </u>	-		┞				_	_	_	_
8	-19—	1	20-	L	.21 <u>—</u>		-22	_	-23		 -24—
9										J.	Ī
i	30										
10	-30— 	1	29— 		28-		-27 <u></u> 		-26— 	Τ	-25
11	_	\dagger	†	╁┈	†	+	\dagger	t	+-	╁~	1
12	-31—	+	32	┼	3¦3—	+	-3 4	-	35	╂	-3 6
13	⅃	ـــــــــــــــــــــــــــــــــــــــ	ل	<u>L</u>	L		<u> </u>	<u>L</u>		1	1

3 - -

A. Description of original monument and accessories and/or subsequent restoration:

G.L.O. notes Nov. 17, 1834 by H. Parke, D.S., set 1/4 section post, Pine 50" S13°W 21 links, Hemlock 10" N26°W 37 links.

B. Description of corner evidence found and/or method applied in restoring or reestablishing corner:

Excavated several locations along township line (proportional to G.L.O. and found nothing, opposite edge mowed field to west and found nothing and 2635 to 2645 feet north of corner M-3) and found $10" \times 10" \times 18"$ pointed stone at 2639.10' north of Corner M-3. Accepted found stone as the best evidence of the original corner.

Corner A-2, T12N-R11E is common with Corner M-2, T12N-R10E.

C. Description of monument for corner and accessories established to perpetuate locating the position of the corner:

Removed stone & perpetuated with standard monument stamped M-2, T12N-R10E. Placed circle of stones and glass around base of monument. N20°E 61.31' set T.C. Remon. tag & spike in W. face 12"Ash. S25°E 21.96' set 1/2" re-rod in E. edge road.
West 33.00' set 1/2" re-rod (not on E-W 1/4 line).
East 33.00' set 1/2" re-rod (not on E-W 1/4 line).
N15°W 64.73' chiseled notch atop W. end 30' of 15" CSP.
N15°E 63.80' chiseled notch atop E. end 30' of 15" CSP.
North 8'± South edge mowed field to West.


Signed by Surveyor's Michigan License No. 23503

KENNETH D DUNTON SURVEYOR

No.

URVE

PESSICREVISED

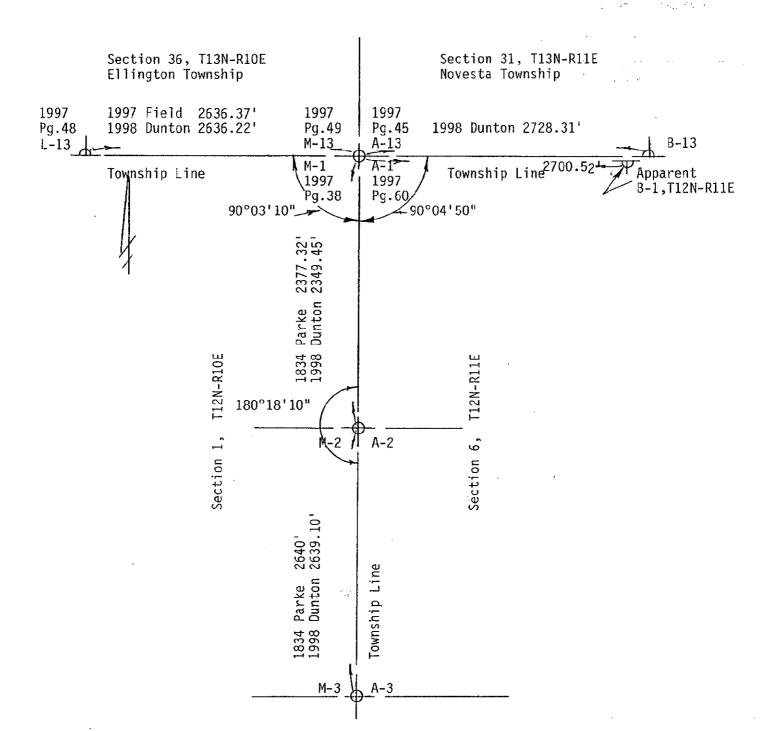

SURVEY & REMONIFMENTATION

MAR 0 2 1999

SECTION