MAR 0.5 1998

SECTION

1007 DEMONUMENTATION DROCDAM

1771	KEMONOPIENTATION	ויואאטטאיז

LAND CORNER RECORDATION CERTIFICATE

For corners in Kingsto Tuscola (County)	n Township Located In: Corner Code #	RECEIVE SER NO. L ST ROV TUSS FERS
1. Public Land Survey	T12NR 11E H-13 T R	D FOR RECORD AND THE PAGE NO.
Property Controlling in Section Miscellaneous	STR STR	in loss
Property in Sec.	S TR	Register of Deeds Stamp & File Number

I, Kenneth D. Dunton, in a field survey on Oct. 3, 1997 do hereby state that under requirements of P.A. 74, Michigan P.A. of 1970, the corner points mentioned in lines 1 and 2 above were in conformance with regulations and rules therefore as required in the current manual of survey instructions of the United States Department of the Interior, Bureau of Land Management or by a decree of a Court of Law and /or that the corner points mentioned in lines 3, 4 and 5 above were in conformance with the rules of the Michigan Board of Land Surveyors or by a Decree of a Court of Law; established, re-established, monumented,

NOTE: Not more than 2 corners, all in the same town and range, may be recorded on this certificate.

	Α	В	C I	D	E	F	G I	Н	1	J I	K 1	L M
1	Γ	T	Π	Γ	<u> </u>	1	П	П		T	T	_
2	-	ģ- 	 	<u>\$</u>		4	\vdash	ֈ —	-	2 -	┢┈	į —
3	<u> </u>	_	-	-	├-	├-	-		 		 	
4	-	 7	\vdash	မှ မှ 	-	9	·] 	-1	 1	1	! 2—
5	<u> </u> -	-	-		├	 -	 	-	-		-	
6	<u></u> 1		1	<u>.</u> '	1	6	1	! .5	3	4	1	3
7	<u> </u>	<u> </u>	<u> </u>	-	├	<u> </u>	<u></u>	_			<u>.</u>	
8	<u> </u>	! 9—-	2	0		1	<u></u> 2	2	2	3	2	4
9	_		<u> </u>		<u> </u>	<u> </u>					-	_
10	3		2	! !9	2	l 28—-	2	i 7	2	 6	-2	5—1
11						-		-		_	-	
12	3	1	3	2	3	3	3	4	3	5	-3	6—
			1		1	ļ	4			1	1	

A. Description of original monument and accessories and/or subsequent restoration:

March 18, 1834 Hervey Parke, D.S. Set quarter section post. Beech 18" N43°W 25 links, March 18, 1834 Hervey Parke, D.S. Set quarter section post. Beech 18" N43" 25 17hks, Hemlock 9" N79°E 11 links. Sept. 9, 1968 M.S.H.D. witness card, R. Fosdick, Survey Chief. 1" pipe. N45°E 66.90' end of curb and gutter, due South 99.90' 24" Maple, S25°W 86.70' power pole. April 29, 1971 L.C.R.C. Page 4 by Rowe, L.S. #11192. Found 1/2" rod in mon. box. N15°E 59.89' cor. conc. curb, N60°E 55.27' cor. conc. curb, N60°W 50.07' cor. conc. curb. July 22, 1971 Survey L-1, Page 139 by Kay, L.S. #14096. Centerline Harrison Road S 1/4 cor. Sec. 34 (mon. box) N35°E 61.0' cor. curb return, N35°W 58.7' cor. curb return. Note: The 1971 L.C.R.C. and 1971 survey both appear to have held the 1/2" rod in the mon. box in the centerline Section A sen't on book of form Section A con't on back of form.

Description of corner evidence found and/or method applied in restoring or reestablishing corner: of M-46

Found I" pipe in place and three accessories that indicate the corner found is in the same position as the 1968 witness card by Fosdick. Accepted 1" pipe as the best evidence of the

original corner.

5. Private Claims

recovered, found as expressed below:

C. Description of monument for corner and accessories established to perpetuate locating the position of the corner:

Removed 1" pipe and placed concrete monument with standard brass cap. Stamped cap H-13, T12N-R11E. Placed monument box in asphalt shoulder over concrete monument. T12N-R11E. Placed monument box in asphalt shoulder over concrete monument. North 19.30' fnd. 1/2" iron rod in mon. box in E-W centerline M-46. S30°W 86.48' fnd. M.S.H.D. tag & spike in W. face p. pole. South 100.43' set T. C. Remon. tag & spike in E. root of 27" Maple. N45°E 68.79' NE cor. of East end conc. curb.

N15°E 79.42' NE cor. of North end conc. curb.

N40°W 64.40' NW cor. of West end conc. curb. West 190.3' ± found 1" pipe (bent) at apparen at apparent cor. H-1, TIIN-RIIE. _pipe (bent_)

Signed by


23503 Surveyor's Michigan License No.

APPROVED

KENNETH * DUNTON * LAND SURVEYOR

PROFESSION

as the South 1/4 corner of Section 34. 1/2" rod appears to be centerline control point. (See Section B of this form). Sept. 14, 1987 Survey L-578, P-070 & 071 by Dunton, L.S. #23503. Fnd. 1" pipe. North 19.16' 1/2" rod in monument box, West 190.4' 1" pipe at N 1/4 cor. Sec. 3, TIIN-RIIE.

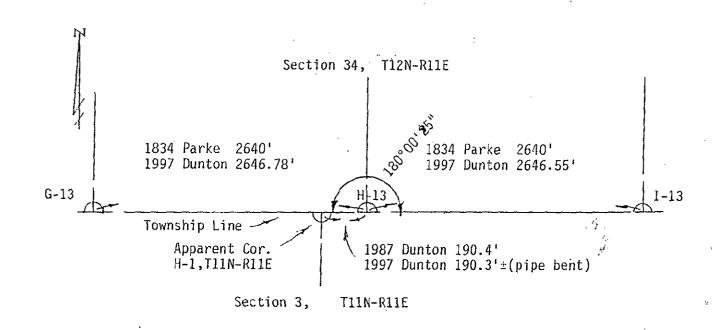

. .