

1996 REMONUMENTATION PROGRAM  
LAND CORNER RECORDATION CERTIFICATE  
Filing Requirement of Act 74, Mich. P.A. 1970

RECEIVED FOR RECORD  
LICEN NO. \_\_\_\_\_ PAGE NO. 88  
ITEMS Fairgrove

96 DEC 10 AM 8:59

*Jon M. Field*  
TUSCOLA COUNTY  
REGISTER OF DEEDS

For corners in FAIRGROVE TWP.

TUSCOLA  
(County)

Located In:

Corner Code #

1. Public Land Survey T 13N R 08E

T \_\_\_\_\_ R \_\_\_\_\_

T 13N R 7E

T \_\_\_\_\_ R \_\_\_\_\_

2. Property Controlling S \_\_\_\_\_ T \_\_\_\_\_ R \_\_\_\_\_

in Section S \_\_\_\_\_ T \_\_\_\_\_ R \_\_\_\_\_

3. Miscellaneous S \_\_\_\_\_ T \_\_\_\_\_ R \_\_\_\_\_

Property in Sec. S \_\_\_\_\_ T \_\_\_\_\_ R \_\_\_\_\_

A-6

M-6

Register of Deeds Stamp & File Number

4. Lot No. \_\_\_\_\_, Recorded Plat \_\_\_\_\_

5. Private Claims \_\_\_\_\_

I, JONATHAN M. FIELD, in a field survey on MAY 17 19 96,

do hereby certify that under requirements of P.A. 74, Michigan P.A. of 1970, the corner points mentioned in lines 1 and 2 above were in conformance with regulations and rules therefore as required in the current manual of survey instructions of the United States Department of the Interior, Bureau of Land Management or by a decree of a Court of Law and/or that the corner points mentioned in lines 3, 4 and 5 above were in conformance with the rules of the Michigan Board of Land Surveyors or by a Decree of a Court of Law; established, re-established, monumented, re-monumented, recovered, found as expressed below:

NOTE: Not more than 4 corners, all in the same town and range, may be recorded on this certificate.

A. Description of original monument and accessories and/or subsequent restoration:

1834 GLO; RISDON, D.S.; SET AS M-6 OF THE ORIGINAL GOVERNMENT SURVEY OF T13N-R7E; POST; SUGAR 10 S23W 23LKS, ELM 12 N36W 11LKS

1975 ROWE ENG.; BECK, P.S.#21559; SURVEY L.458, PG.215-217; FND P-K NAIL; EAST 22.20' TOP CENTER N END 24" CMP, N40W 33.69' RLS 11192 TAG IN T/P, S45W 31.18' STOP SIGN POST

1976 BECK, P.S.#21559; LCRC PG.24; SAME OBJECT AND WITS AS 1975 SURVEY ABOVE

B. Description of corner evidence found and/or method applied in restoring or reestablishing corner:

1996 ROWE ENG.; FIELD, P.S.#37276; FND. NO EVIDENCE OF MONUMENT AT CORNER. REESTABLISHED POSITION FOR CORNER BY TRAVERSE FROM RECOVERED IRONS OF 1975 SURVEY CITED ABOVE

ACCEPTED LOCATION OF CORNER FROM RETRACEMENT OF 1975 SURVEY AS BEST POSITION OF THE ORIGINAL CORNER

C. Description of monument for corner and accessories established to perpetuate locating the position of the corner:

A-6 SET STANDARD REMON MONUMENT STAMPED "M 6 T13N R7E" IN MON. BOX

N37°W, 31.36' SET 1/2" ROD W/CAP #37276

S25°E, 54.68' SET CHIS. NOTCH IN TOP S. END 24" CMP

S62°W, 32.58' CENTER OF STOP SIGN POST

S39°W, 29.74' SET 1/2" ROD W/CAP #37276


N76°W, 53.27' SET 1/2" ROD W/CAP #37276

N48°E, 15.83' SET 1/2" ROD W/CAP #37276

NOTE: THIS CORNER IS COMMON WITH M-6 T13N-R7E

Signed by *Jonathan M. Field* Date 11-27-96

Surveyor's Michigan License No. 37276

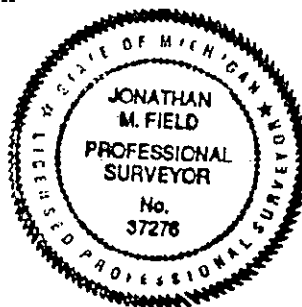

FORM APPROVED BY MICHIGAN STATE BOARD OF LAND SURVEYORS, JAN. 28, 1971  
REVISED MAY 14, 1975  
REVISED JAN., 1983  
ADAPTED FOR WORD PROCESSING MARCH, 1993

APPROVED

11-27-96

*FOR  
F.B.E.  
R.L.B.*

29

