

**1996 REMONUMENTATION PROGRAM  
LAND CORNER RECORDATION CERTIFICATE**  
Filing Requirement of Act 74, Mich. P.A. 1970

RECEIVED FOR RECORD  
LIBER NO. \_\_\_\_\_ PAGE NO. 84  
FILE NO. Fairgrove

96 DEC 10 AM 8:59

For corners in FAIRGROVE TWP.

TUSCOLA Located In: \_\_\_\_\_ Corner Code # \_\_\_\_\_  
(County)

1. Public Land Survey T 13N R 08E \_\_\_\_\_  
T \_\_\_\_\_ R \_\_\_\_\_  
T 13N R 7E \_\_\_\_\_  
T \_\_\_\_\_ R \_\_\_\_\_

2. Property Controlling S \_\_\_\_\_ T \_\_\_\_\_ R \_\_\_\_\_  
in Section S \_\_\_\_\_ T \_\_\_\_\_ R \_\_\_\_\_

3. Miscellaneous S \_\_\_\_\_ T \_\_\_\_\_ R \_\_\_\_\_  
Property in Sec. S \_\_\_\_\_ T \_\_\_\_\_ R \_\_\_\_\_

*[Signature]*  
TUSCOLA COUNTY  
REGISTER OF DEEDS

Register of Deeds Stamp & File Number

4. Lot No. \_\_\_\_\_, Recorded Plat \_\_\_\_\_  
5. Private Claims \_\_\_\_\_

	A	B	C	D	E	F	G	H	I	J	K	L	M
1													
2	6	5	4	3	2	1							
3													
4	7	8	9	10	11	12							
5													
6	18	17	16	15	14	13							
7													
8	19	20	21	22	23	24							
9													
10	30	29	28	27	26	25							
11													
12	31	32	33	34	35	36							
13													

I, JONATHAN M. FIELD, in a field survey on MAY 17 1996, do hereby certify that under requirements of P.A. 74, Michigan P.A. of 1970, the corner points mentioned in lines 1 and 2 above were in conformance with regulations and rules therefore as required in the current manual of survey instructions of the United States Department of the Interior, Bureau of Land Management or by a decree of a Court of Law and/or that the corner points mentioned in lines 3, 4 and 5 above were in conformance with the rules of the Michigan Board of Land Surveyors or by a Decree of a Court of Law; established, re-established, monumented, re-monumented, recovered, found as expressed below:

NOTE: Not more than 4 corners, all in the same town and range, may be recorded on this certificate.

- A. Description of original monument and accessories and/or subsequent restoration:
- 1834 GLO; RISDON, D.S.; SET AS M-10 OF THE ORIGINAL GOVERNMENT SURVEY OF T13N-R7E; POST; LYNN 10 N28W 16LKS, W MAPLE 14 S28E 36LKS
  - 1981 ROWE, P.S.#11192; LCRC PG.35; SET P-K BY SINGLE PROP. MEAS; N89W 33.00' 1/2" ROD, NORTH 267.00' P-K W/FLAG., WEST 2.8 C/L VASSAR RD
  - 1981 FOKENS, P.S.#21567; SURVEY L.520, PG.1298-99; NO OBJECT STATED; SAME WITS AS 1981 LCRC
  - 1989 ROWE ENG.; SZYSZKOSKI, P.S.#33986; SURVEY L.597, PG.925-28; FND P-K; WEST 32.20' E FACE 2" PIPE, WEST 33.05' ROD #11192; N20E 26.98' 1/2" ROD, N25W 28.97' 1/2" ROD, WEST 2.8' C/L VASSAR RD
  - 1989 DUNTON, P.S.#23503; SURVEY L.608, PG.1052; FND P-K; N20E 27.0' 1/2" ROD, N20W 29.0' 1/2" ROD, WEST 33.0' ROD & CAP #11192, EAST 197.6' PK IN N FACE P/P


NOTE: THIS CORNER IS COMMON WITH M-10 T13N-R7E

- B. Description of corner evidence found and/or method applied in restoring or reestablishing corner:
- 1996 ROWE ENG.; FIELD, P.S.#37276; FND. P-K NAIL 2.8' E. OF C/L ASPH. ROAD N-S & ON FIELD DIVISION LINE E-W. RECOVERED 2 PREVIOUS WITNESSES WHICH INDICATE THAT FND P-K NAIL IS IN SAME POSITION AS 1981 LCRC CITED ABOVE

ACCEPTED FND. P-K NAIL AS BEST EVIDENCE OF ORIGINAL CORNER POSITION

- C. Description of monument for corner and accessories established to perpetuate locating the position of the corner:
- A-10 REPLACED FND. P-K NAIL W/ STANDARD REMON MONUMENT STAMPED "M 10 T13N R7E" IN MON. BOX
  - N18°E, 27.01' FND. 1/2" ROD
  - N30°W, 28.97' FND. 1/2" ROD
  - WEST, 33.09' FND. 1/2" ROD W/CAP #11192
  - WEST, 32.10' FND. 1 1/2" GALV. POST
  - EAST, 197.49' FND. P-K NAIL IN N. FACE P.POLE

Signed by Jonathan M. Field Date 11-6-96  
Surveyor's Michigan License No. 37276

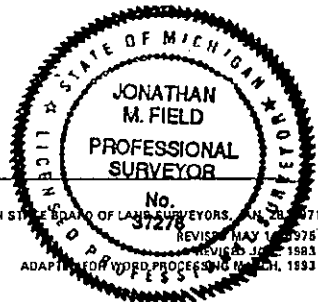

APPROVED  
10-4-96

FORM APPROVED BY MICHIGAN STATE BOARD OF LAND SURVEYORS, JAN. 28, 1971  
REVISOR MAY 1, 1975  
ADAPTED FOR WORD PROCESSING MARCH, 1983

MAY 20 1997  
COMMISSION



GILFORD ROAD

M-11

179°51'24"

A-11

SEC. 25  
T13N-R7E

M-10

180°00'24"

A-10

VASSAR ROAD

SEC. 30  
T13N-R8E

1996 REI 2628.89'  
1834 GLO 2640'

1996 REI 2628.83'  
1834 GLO 2640'

M-9

180°00'36"

A-9

DECKERVILLE ROAD