

LAND CORNER RECORDATION CERTIFICATE

Filing Requirement of Act 74, Mich. P.A. 1970 1995 REMONUMENTATION PROGRAM

For corners in FAIRGROVE TWP.

TUSCOLA

(County)

Located In:

Corner Code #

1. Public Land Survey

T 13N R 08E

C-13

2. Property Controlling
in Section

S T R
S T R

3. Miscellaneous
Property in Sec.

S T R
S T R

4. Lot No. _____, Recorded Plat _____

5. Private Claims _____

I, JONATHAN M. FIELD, in a field survey on SEPTEMBER 28 19 95, do hereby certify that under requirements of P.A. 74, Michigan P.A. of 1970, the corner points mentioned in lines 1 and 2 above were in conformance with regulations and rules therefore as required in the current manual of survey instructions of the United States Department of the Interior, Bureau of Land Management or by a decree of a Court of Law and/or that the corner points mentioned in lines 3, 4 and 5 above were in conformance with the rules of the Michigan Board of Land Surveyors or by a Decree of a Court of Law; established, re-established, monumented, re-monumented, recovered, found as expressed below:

NOTE: Not more than 4 corners, all in the same town and range, may be recorded on this certificate.

A. Description of original monument and accessories and/or subsequent restoration:

1821 GLO; WAMPLER, D.S.; SET POST; LYNN 18 S8 1/2E 19LKS., ELM 19 N9 1/2E 25LKS.
1972 ROWE ENG.; ROWE, P.S.#11192; SURVEY L.1 PG.451; FND IRON BAR W/ HANDLE; N35W 45.88' CTR N. END CMP, S50W 37.49' CTR S. END CMP, N45E 35.00' T-IRON
1972 ROWE, P.S.#11192; LCRC PG.10; FND IRON BAR W/ HANDLE; SAME WITS AS 1972 SURVEY ABOVE

B. Description of corner evidence found and/or method applied in restoring or reestablishing corner:

1995 ROWE ENG.; FIELD, P.S.#37276; FND 3/4" ROD W/ HANDLE 2'S. OF C/L GRAVEL ROAD E-W & 4'E. OF C/L ASPH. ROAD TO N.; RECOVERED 2 PREV. WITS INDICATING THAT FND IRON IS IN SAME POSITION AS 1972 IRON BAR CITED ABOVE;

ACCEPTED FND. ROD AS BEST EVIDENCE OF ORIGINAL CORNER POSITION

C. Description of monument for corner and accessories established to perpetuate locating the position of the corner:

C-13 REPLACED FND BAR W/ STANDARD REMON MONUMENT STAMPED CAP C13 T13N R8E
N45°W, 45.88' TOP CENTER OF N. END 48" CMP
S50°W, 37.49' TOP CENTER OF S. END 48" CMP
S50°E, 13.48' SET 1/2" ROD W/CAP #37276
N40°E, 29.91' SET 1/2" ROD W/CAP #37276

RECEIVED FOR RECORD
LIBER NO. _____ PAGE NO. _____
FILING NO. # 20
FAIRGROVE TWP
95 NOV 15 PM 3:28
VIRGINIA K. MILLER
TUSCOLA COUNTY
REGISTER OF DEEDS

Register of Deeds Stamp & File Number


| | A | B | C | D | E | F | G | H | I | J | K | L | M |
|----|----|----|----|----|----|----|---|---|---|---|---|---|---|
| 1 | | | | | | | | | | | | | |
| 2 | 6 | 5 | 4 | 3 | 2 | 1 | | | | | | | |
| 3 | | | | | | | | | | | | | |
| 4 | 7 | 8 | 9 | 10 | 11 | 12 | | | | | | | |
| 5 | | | | | | | | | | | | | |
| 6 | 18 | 17 | 16 | 15 | 14 | 13 | | | | | | | |
| 7 | | | | | | | | | | | | | |
| 8 | 19 | 20 | 21 | 22 | 23 | 24 | | | | | | | |
| 9 | | | | | | | | | | | | | |
| 10 | 30 | 29 | 28 | 27 | 26 | 25 | | | | | | | |
| 11 | | | | | | | | | | | | | |
| 12 | 31 | 32 | 33 | 34 | 35 | 36 | | | | | | | |
| 13 | | | | | | | | | | | | | |

Signed by Jonathan M. Field

Date 11-15-95

Surveyor's Michigan License No. 37276

FORM APPROVED BY MICHIGAN STATE BOARD OF LAND SURVEYORS, JAN. 28, 1971
REVISED MAY 14, 1975
REVISED JAN., 1983
ADAPTED FOR WORD PROCESSING MARCH, 1993

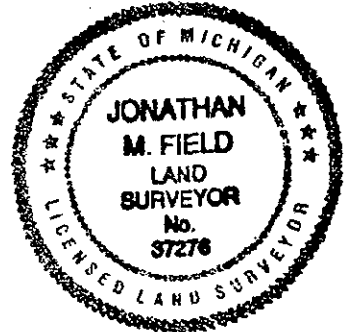


APPROVED

11-6-95

DEC 6 1995

COPY

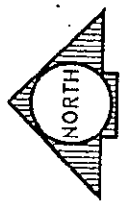

SE 1/4
SEC 31
T13N-R8E

SW 1/4
SEC 32
T13N-R8E

