

SURVEY & REMONUMENTATION

DEC 0 8 1993

COMMISSION

COPY

1993 REMONUMENTATION PROGRAM LAND CORNER RECORDATION CERTIFICATE Filing Requirement of Act 74, Mich. P.A. 1970 FAIRGROVE TOWNSHIP

For corners in
TUSCOLA
(County)

Located In:

Corner Code //

1. Public Land Survey

T 13N R 8E

M-2

T R

T R

T R

T R

2. Property Controlling
in Section

S T R

S T R

3. Miscellaneous
Property in Sec.

S T R

S T R

4. Lot No. _____, Recorded Plat _____

5. Private Claims _____

RECEIVED FOR RECORD
LIBER NO. _____ PAGE NO. 68
FILING NO. Fairgrove Twp.
93 NOV -2 PM 3:56
VIRGINIA H. MALLARD
TUSCOLA COUNTY
REGISTER OF DEEDS

Register of Deeds Stamp & File Number

I, Kenneth D. Dunton, in a field survey on Aug. 28, 1993

do hereby certify that under requirements of P.A. 74, Michigan P.A. of 1970, the corner points mentioned in lines 1 and 2 above were in conformance with regulations and rules therefore as required in the current manual of survey instructions of the United States Department of the Interior, Bureau of Land Management or by a decree of a Court of Law and/or that the corner points mentioned in lines 3, 4 and 5 above were in conformance with the rules of the Michigan Board of Land Surveyors or by a Decree of a Court of Law; established, re-established, monumented, re-monumented, recovered, found as expressed below:

NOTE: Not more than 4 corners, all in the same town and range, may be recorded on this certificate.

A. Description of original monument and accessories and/or subsequent restoration:

1821 G.L.O. Notes
Joseph Wampler, D.S.
Set 1/2 mile post
? 5" S40°W 3.96'
? 5" N36°E 8.58'

Nov. 7, 1891 G. B. Felton, County Surveyor
Set from measurements
Bur Oak 8" N8 1/2°W 79.86'
Bur Oak 3" N20 1/4°E 64.68'
North 2587.86' to cor. M-1
South 2587.86' to cor. M-3

Note: Section A. continued on back of form.

B. Description of corner evidence found and/or method applied in restoring or reestablishing corner:

Found 1/2" rod to surface. Also found 1 1/2" o. d. pipe & remains of mon. box 6" deep.
Accepted rod and pipe per surveys and Act 74 of record.

C. Description of monument for corner and accessories established to perpetuate locating the position of the corner:

Removed rod & pipe and set standard monument with 2" brass cap stamped corner M-2, T13N-R8E, placed monument box over monument.
S00°13'40"W 29.66' found p. k. nail & disc #11192 at apparent cor. A-4, T13N-R9E.
S18°55'W 45.62' found 1/2" re-rod in road shoulder.
N41°12'W 20.50' found 1/2" re-rod in road shoulder.
S59°52'E 58.90' set T. C. Re-mon. tag & spike over #11192 tag in p. pole.
S18°18'E 44.49' found 1/2" re-rod in road shoulder.

Signed by

Kenneth D. Dunton

Date Oct. 25, 1993

Surveyor's Michigan License No. 23503

APPROVED

10-25-93



Continued from Section A. on front of this form:

Nov. 1969 Witness card - source unknown.

Placed 1 1/4" pipe.

S55°E 59.15' p. p.

West 22.38' 14" elm.

Dec. 29, 1972 Survey Liber 2 - Pages 393 & 394 by David T. Rowe, R.L.S. #11192. No mention of object found or set. No accessories given.

Nov. 20, 1975 Survey Liber 456 - Page 630 by Robert G. Kay, R.L.S. #14096. E 1/4 cor. Sec. 1 (mon. box).

S60°E 59.13 p. p.

West 28.30' nail in 18" stump.

Oct. 6, 1988 Act 74, Fairgrove Township, Page 46 by Paul N. Brown, R.L.S. #33134. Found rod (standard corner) previously measured and used by MSHD plans.


South 29.66' W 1/4 cor. Sec. 7, T13N-R9E.

S25°E 44.57' set rod in road shoulder.

S25°W 45.49' set rod in road shoulder.

N45°W 21.21' set rod in road shoulder.

S45°E 58.94' set tag #11192 in NNW face p. p.

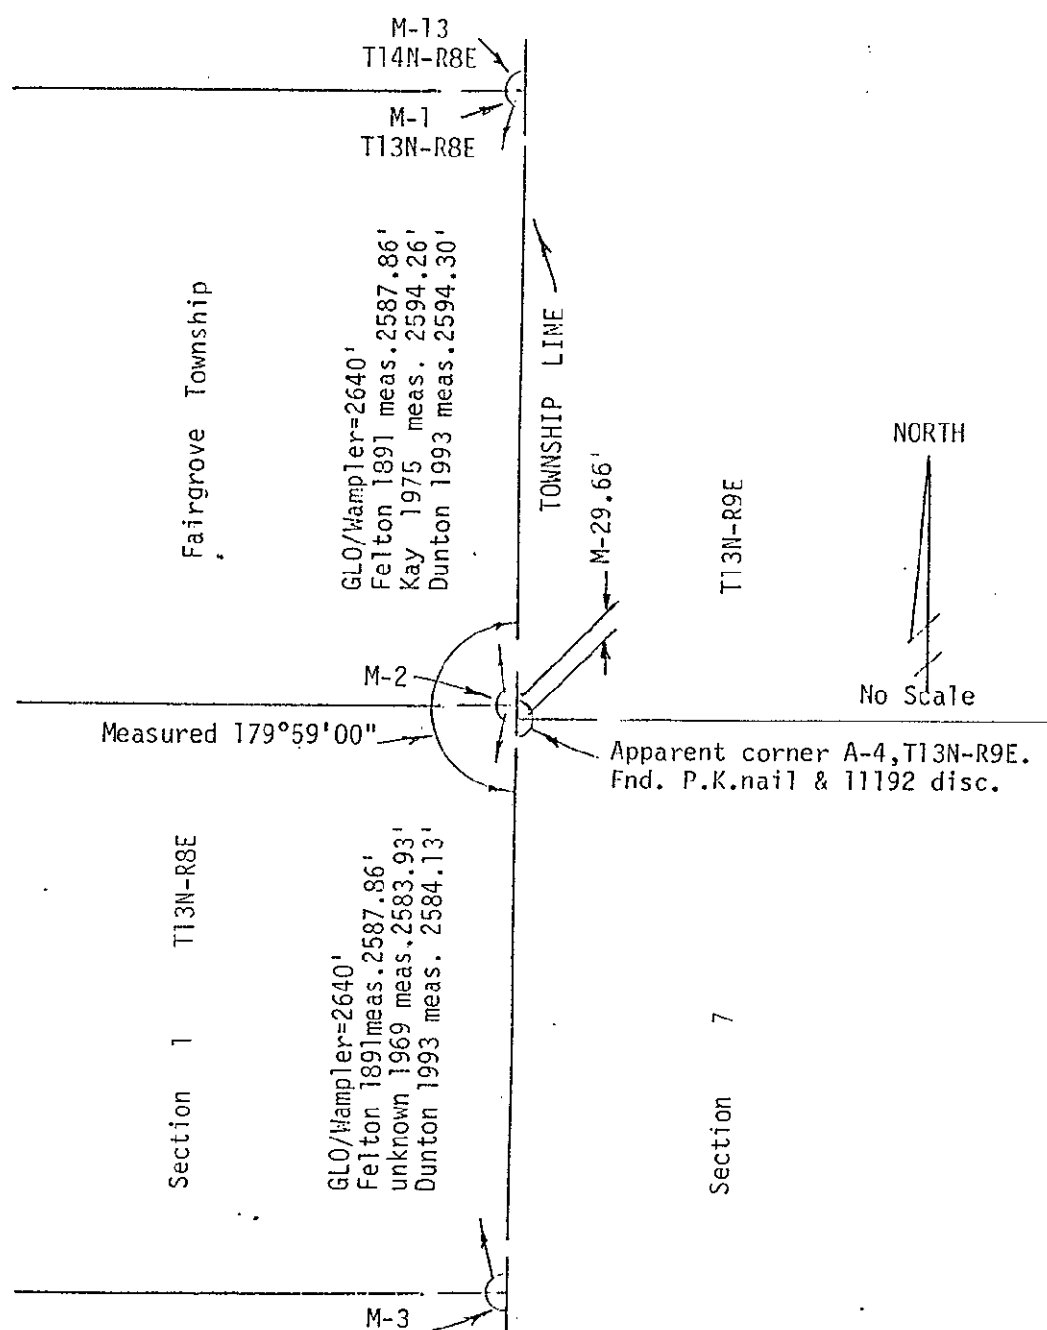

COPY