

COMMISSION

For corners in

TUSCOLA

(Contd.)

Located In:

Corner Code 11

- |                                    |   |            |   |           |     |
|------------------------------------|---|------------|---|-----------|-----|
| 1. Public Land Survey              | T | <u>13N</u> | R | <u>8E</u> | M-8 |
|                                    | T | _____      | R | _____     |     |
|                                    | T | _____      | R | _____     |     |
|                                    | T | _____      | R | _____     |     |
| 2. Property Controlling in Section | S | _____      | T | _____     | R   |
|                                    | S | _____      | T | _____     | R   |
| 3. Miscellaneous                   | S | _____      | T | _____     | R   |
| Property in Sec.                   | S | _____      | T | _____     | R   |

4. Lot No. \_\_\_\_\_, Recorded Plat \_\_\_\_\_
5. Private Claims \_\_\_\_\_

I, Kenneth D. Dunton in a field survey on Aug. 15, 1993  
do hereby certify that under requirements of P.A. 74, Michigan P.A. of 1970, the corner points mentioned  
in lines 1 and 2 above were in conformance with regulations and rules therefore as required in the  
current manual of survey instructions of the United States Department of the Interior, Bureau of Land  
Management or by a decree of a Court of Law and/or that the corner points mentioned in lines 3, 4 and 5  
above were in conformance with the rules of the Michigan Board of Land Surveyors or by a Decree of a  
Court of Law; established, re-established, monumented, re-monumented, recovered, found as  
expressed below:

**NOTE:** Not more than 4 corners, all in the same town and range, may be recorded on this certificate.

A. Description of original monument and accessories and/or subsequent restoration:

1821 G.L.O. Notes  
Joseph Wampler, D.S.

Set 1/2 mile post

Birch 5" N19°E 5.28'

Hemlock 10" S21 1/2°W 11.22'

Nov., 1969 Witness card - source unknown.

Found 1 1/2" rod - replaced with 3/4" pipe in mon. box.

N45°W 26.34' " + " on North headwall.

S60°W 24.70' " + " on South headwall.

N60°E 54.14' p. p.

Note: Section A. continued on back of form.

B. Description of corner evidence found and/or method applied in restoring or reestablishing corner:

Found and accepted 5/8" rod in monument box per survey & Act 74 of record.

Top of rod in poor condition, would not fit bore in brass cap. Removed rod (24" long) and placed 1/2" x 18" pipe, placed 1/2" x 18" rod in pipe.

C. Description of monument for corner and accessories established to perpetuate localing the position of the corner:

Placed 2" diameter brass cap over 1/2" rod & encased in concrete. Stamped brass cap, corner M-8, T13N-R8E.

South 113.58' found 1/2" rod at apparent cor. A-10, T13N-R9E.

S53°34'W 38.22' set T. C. Re-mon. tag & spike above MDOT tag in N. face 4" x 4" post.

N57°34'W 26.34' found "+" chisled atop concrete headwall.

N53°32'E 54.03' set T. C. Re-mon. tag & spike over MDOT tag in p.p.

East 45.00' set 1/2" x 18" rod & cap #23503 on top of ditch bank.


Signed by

Date Oct. 25, 1993

Surveyor's Michigan License No. 23503

**APPROVED**

10-25-93

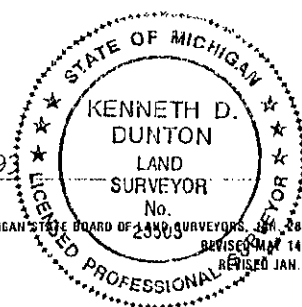

FORM APPROVED BY MICHIGAN STATE BOARD OF LAND SURVEYORS, JAN. 28, 1971  
REVISED MAY 14, 1975  
REVISED JAN. 1983

Continued from Section A. on front of this form:

March 12, 1984 Act 74, Fairgrove Township, Page 44 by Kay Don Fluke, R.L.S. #18988 with Michigan Department of Transportation. Found 3/4" rod in monument box.

West 68.94' Elm 15".

S65°W 22.15' cross on East end of concrete headwall.

N50°W 28.23' cross on SW corner of concrete headwall.

N60°E 53.98' p.p.

South 113.62' 3/4" rod (W 1/4 cor. Sec. 30, Almer Twp.)

3.2' East of centerline of Unionville Road.

Jan. 17, 1986 Survey Liber 561 - Pages 612 & 613 by Jack N. Owens, R.L.S. #20709.

Found 3/4" round bar in mon. box (under asph. pave.).

N45°W 26.34' found "+" chis. on N. hdwl.

N60°E 54.00' MSHD nail & tap in p.p.

S45°W 38.26' nail & flag in N. face 4 x 4.

(wood underground tele. marker post)

Per survey M-8 to M-9 = 2628.46'

