

1996 REMONUMENTATION PROGRAM
LAND CORNER RECORDATION CERTIFICATE

Filing Requirement of Act 74, Mich. P.A. 1970

RECORDED FOR RECORD
LIBER NO. 33
PAGE NO. 33

96 DEC 10 AM 9:00

For corners in WISNER TWP.
TUSCOLA
(County)

Located in:

Corner Code #

1. Public Land Survey

T 14N R 07E

T 14N R 08E

T 14N R 08E

M-4

A4

A4

TUSCOLA COUNTY
REGISTER OF DEEDS

Register of Deeds Stamp & File Number

	A	B	C	D	E	F	G	H	I	J	K	L	M
1													
2	6	5	4	3	2	1							
3													
4	7	8	9	10	11	12							
5													
6	18	17	16	15	14	13							
7													
8	19	20	21	22	23	24							
9													
10	30	29	28	27	26	25							
11													
12	31	32	33	34	35	36							
13													

I, JONATHAN M. FIELD, in a field survey on MAY 21 19 96, do hereby certify that under requirements of P.A. 74, Michigan P.A. of 1970, the corner points mentioned in lines 1 and 2 above were in conformance with regulations and rules therefore as required in the current manual of survey instructions of the United States Department of the Interior, Bureau of Land Management or by a decree of a Court of Law and/or that the corner points mentioned in lines 3, 4 and 5 above were in conformance with the rules of the Michigan Board of Land Surveyors or by a Decree of a Court of Law; established, re-established, monumented, re-monumented, recovered, found as expressed below:

NOTE: Not more than 4 corners, all in the same town and range, may be recorded on this certificate.

A. Description of original monument and accessories and/or subsequent restoration:

1834 GLO; O.RISDON, D.S.; SET 1/4 POST IN MARSH; NO WITS GIVEN
1950 WIT CARD @ ROWE ENG.; SET 3/4" PIN; EAST 60.3' SPIKE IN P/P, SWLY 54.8' SPIKE IN MAPLE
1975 ROWE, P.S.#11192; LCRC PG.18; FND. 5/8" IRON; EAST 60.37' TAG IN PP; S55E 79.65' NW'LY
FACE OF GRAIN BIN; WEST 5.8' C/L PAVEMENT N-S
1987 WADE-TRIM; MCGINNIS, P.S.#18999; FND IRON; SAME WITS AS 1975 LCRC ABOVE.

B. Description of corner evidence found and/or method applied in restoring or reestablishing corner:

1995 ROWE ENG.; FIELD, P.S.#37276; FND 3/4" ROD IN MON BOX 5.8' E. OF C/L ASPH. ROAD N-S & ON OCCUPIED FIELD LINE E-W; RECOVERED 1 PREVIOUS WITNESS WHICH INDICATES THAT FND ROD IS IN SAME POSITION AS 1950 WITNESS CARD CITED ABOVE

ACCEPTED FND ROD IN MON BOX AS BEST EVIDENCE OF ORIGINAL CORNER POSITION

C. Description of monument for corner and accessories established to perpetuate locating the position of the corner:

M-4 SET 5/8" ROD W/ STANDARD REMON CAP STAMPED "M4 T14N R7E" OVER FND 3/4" ROD ENCASED BOTH IN CONC. IN MON. BOX
EAST, 60.37' FND. NAIL W/TAG IN P. POLE
S55°E, 79.65' NW'LY FACE OF METAL STORAGE BIN
WEST, 33.01' FND. ROD W/CAP #33134
N40°E, 16.11' FND. ROD W/CAP #33134
S30°E, 17.70' FND. ROD W/CAP #33134
S45°W, 31.50' FND. ROD W/CAP #33134


NOTE: THIS CORNER IS COMMON WITH A-4 T14N-R8E

Signed by Jonathan M. Field
Surveyor's Michigan License No. 37276

Date 12-4-96

APPROVED
12-2-98

FORM APPROVED BY MICHIGAN STATE BOARD OF LAND SURVEYORS, JAN. 28, 1971

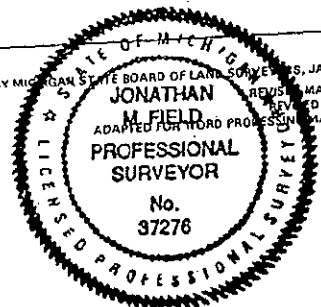

MAY 20 1997

