

1993

1993 REMONUMENTATION PROGRAM
LAND CORNER RECORDATION CERTIFICATE
Filing Requirement of Act 74, Mich. P.A. 1970

For corners in **COMMISSION**

S. AKRON TOWNSHIP

TUSCOLA
(County)

Located In:

Corner Code ##

1. Public Land Survey

T 14N R 8E

M-5

T R

T R

T R

2. Property Controlling
in Section

S T R

S T R

3. Miscellaneous

S T R

Property in Sec.

S T R

4. Lot No. , Recorded Plat

5. Private Claims

RECEIVED FOR RECORD
LIBER NO. PAGE NO. 25
FILED IN S. Akron
93 DEC 10 PM 12:02
VIRGINIA L. HARRIS
TUSCOLA COUNTY
REGISTER OF DEEDS

Register of Deeds Stamp & File Number

I, Kenneth D. Dunton, in a field survey on Sept. 5, 19 93,
do hereby certify that under requirements of P.A. 74, Michigan P.A. of 1970, the corner points mentioned
in lines 1 and 2 above were in conformance with regulations and rules therefore as required in the
current manual of survey instructions of the United States Department of the Interior, Bureau of Land
Management or by a decree of a Court of Law and/or that the corner points mentioned in lines 3, 4 and 5
above were in conformance with the rules of the Michigan Board of Land Surveyors or by a Decree of a
Court of Law; established, re-established, monumented, re-monumented, recovered, found as
expressed below:

**NOTE: Not more than 4 corners, all in the same town and range, may be recorded
on this certificate.**

A. Description of original monument and accessories and/or subsequent restoration:

1821 G.L.O. Notes

Joseph Wampler, D.S.

Set Post cor. Sec. 12 & 13

Reech 10" S74°W 3.30'

Beech 16" N53°E 7.92'

April 20, 1970 & Sept. 24, 1974 Act 74, T14N-R8E, Page 12
by John D. Albright, R.L.S. #10057. 1/2" re-rod.

SE 72.75' p. pole

S.S.E. 89.80' 30" maple

S.W. 42.53' M.S.H.D. tag in 14" ash

N.W. 50.60' M.S.H.D. tag in 24" maple

North 8' + centerline Hoppe Road

Note: Section A. continued on back of form.

B. Description of corner evidence found and/or method applied in restoring or reestablishing corner:

Found and accepted 1/2" iron rod in mon. box per Act 74's and survey of record.

	A	B	C	D	E	F	G	H	I	J	K	L	M
2	6	5	4	3	2	1							
3													
4	7	8	9	10	11	12							
5													
6	18	17	16	15	14	13							
7													
8	19	20	21	22	23	24							
9													
10	30	29	28	27	26	25							
11													
12	31	32	33	34	35	36							
13													

COPY

C. Description of monument for corner and accessories established to perpetuate locating the position of the corner:

Placed 2" brass cap stamped corner M-5, T14N-R8E over 1/2" rod in existing mon. box.
Encased rod & cap in concrete.

S88°02'E 22.00' found p. k. nail in asphalt pavement.

S43°05'E 72.72' set T. C. Re-mon. tag & spike over MSHD tag in NE face of p. pole.

S60°55'W 40.25' set 1/2" x 24" rod & cap #23503 at back of curb.

N39°14'W 48.74' set 1/2" x 24" rod & cap #23503 at back of curb.

N46°26'E 47.40' set 1/2" x 24" rod & cap #23503 at back of curb.

Signed by


Date Nov. 22, 1993

Surveyor's Michigan License No. 23503

APPROVED
11-22-93

J.P.E.
J.M.T.
J.H.N.

FORM APPROVED BY MICHIGAN STATE BOARD OF LAND SURVEYORS, JAN. 28, 1971
REVISED MAY 14, 1975
REVISED JAN., 1983

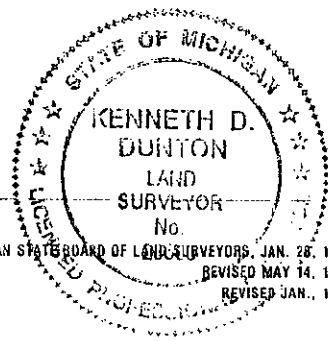

Section A. continued from front of form.

Nov. 4, 1974 Survey Liber 445, Page 762 by David T. Rowe, R.L.S. #11192. Found 5/8" rod.

West 49.74' p.p.

East 51.35' p.p.

Northeast 60.44' SW cor. bridge rail

May 21, 1980 Act 74, T14N-R8E, Page 45 by Douglas W. Hooth, R.L.S. #7966. Found 1/2" iron rod as per L.C.R.C. 9-24-74, Akron, Pg. 12.


Set monument box over 1/2" iron rod.

N37°W 17" maple 59.60'

N75°E center road sign post 59.95'

S42°E p. pole 72.76'

S60°W t. pole 58.00'

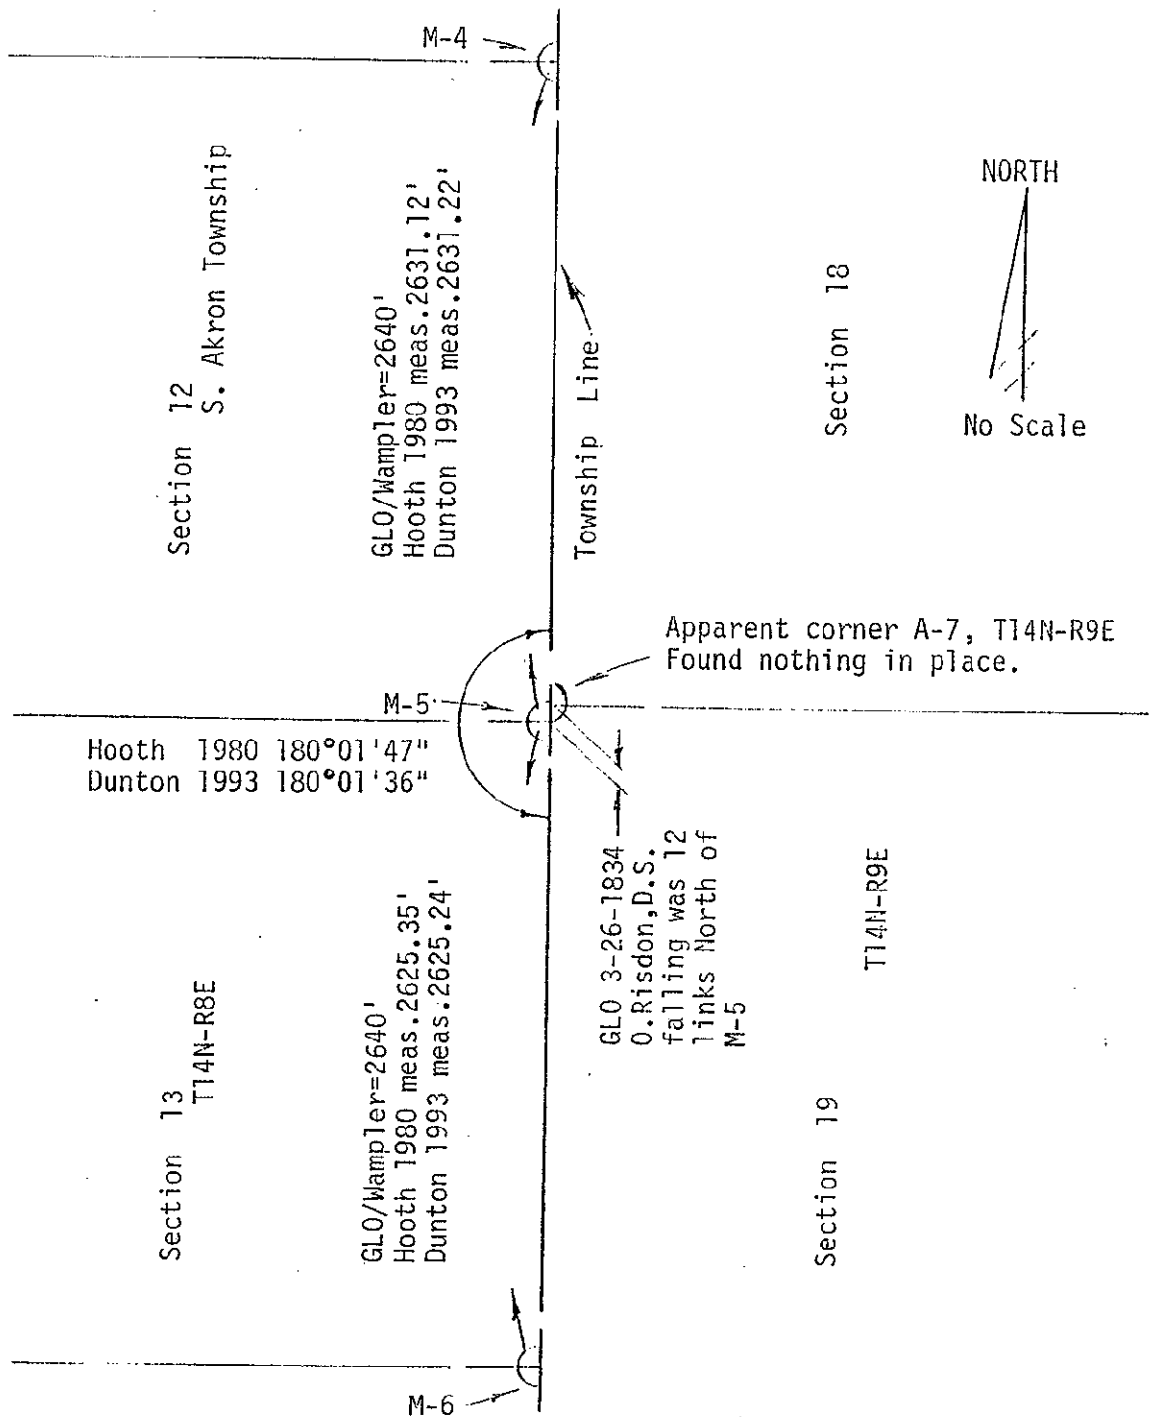

COPY