

1997 REMONUMENTATION PROGRAM
LAND CORNER RECORDATION CERTIFICATE
Filing Requirement of Act 74, Mich. P.A. 1970

RECEIVED FOR RECORD
LIBER NO. _____ PAGE NO. _____
FILE NO. #57
COLUMBIA TOWNSHIP
97 OCT -7 PM 3:02
TUSCOLA COUNTY
REGISTER OF DEEDS

For corners in: COLUMBIA TWP.

TUSCOLA (County)	Located In:	Corner Code #
1. Public Land Survey	T 14N R 09E	G-13
	T _____ R _____	
	T _____ R _____	
	T _____ R _____	
2. Property Controlling in Section	S _____ T _____ R _____	
	S _____ T _____ R _____	
3. Miscellaneous Property in Sec.	S _____ T _____ R _____	
	S _____ T _____ R _____	
4. Lot No. _____	Recorded Plat _____	
5. Private Claims _____		

Register of Deeds Stamp & File Number

	A	B	C	D	E	F	G	H	I	J	K	L	M
1													
2	6	5	4	3	2	1							
3													
4	7	8	9	10	11	12							
5													
6	18	17	16	15	14	13							
7													
8	19	20	21	22	23	24							
9													
10	30	29	28	27	26	25							
11													
12	31	32	33	34	35	36							
13													

I, JONATHAN M. FIELD, in a field survey on JULY 23 19 97, do hereby certify that under requirements of P.A. 74, Michigan P.A. of 1970, the corner points mentioned in lines 1 and 2 above were in conformance with regulations and rules therefore as required in the current manual of survey instructions of the United States Department of the Interior, Bureau of Land Management or by a decree of a Court of Law and/or that the corner points mentioned in lines 3, 4 and 5 above were in conformance with the rules of the Michigan Board of Land Surveyors or by a Decree of a Court of Law; established, re-established, monumented, re-monumented, recovered, found as expressed below:


NOTE: Not more than 4 corners, all in the same town and range, may be recorded on this certificate.

A. Description of original monument and accessories and/or subsequent restoration:
1835 GLO; PARKE, D.S.; SET POST; W. ASH 18 N72 1/2E 27LKS., BEECH 12 N55 1/2W 43LKS.
1988 ROWE; BROWN, P.S.#33134; SURVEY L.587 PG.754-755; CORNER SHOWN; NO OBJECT STATED; NO WITS GIVEN

B. Description of corner evidence found and/or method applied in restoring or reestablishing corner:
1997 ROWE; FIELD, PS#37276; FND. 2 1/2" PIPE IN MON. BOX

ACCEPTED FND PIPE AS BEST AVAILABLE EVIDENCE OF ORIGINAL CORNER POSITION

C. Description of monument for corner and accessories established to perpetuate locating the position of the corner:
G-13 SET 5/8" ROD W/ STD. REMON. CAP STAMPED G 13 T14N R9E INSIDE FND. PIPE, ENCASED IN CONC. IN MON. BOX
EAST, 24.73' FND. 2 1/2" PIPE IN MON. BOX APPARENT G-1 T13N-R9E
S75°W, 106.31' P-K NAIL W/TAG #37276 IN N. FACE P.POLE (SET P-K NAIL W/TAG)
N47°W, 76.03' P-K NAIL W/TAG #37276 IN NE FACE P.POLE (SET P-K NAIL W/TAG)
S69°E, 40.70' P-K NAIL W/TAG #11192 IN GUARD RAIL POST (FND P-K NAIL W/TAG)
N65°E, 41.97' P-K NAIL W/TAG #11192 IN GUARD RAIL POST (FND P-K NAIL W/TAG)

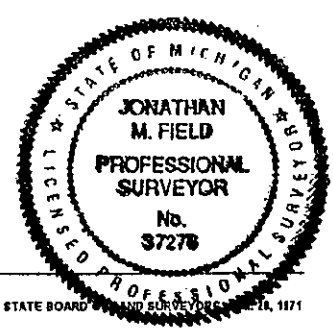

Signed by Jonathan M. Field Date 9-10-97
Surveyor's Michigan License No. 37276

SURVEYOR
REMONUMENTATION

APPROVED
9-9-97
HOD
JFF
RFB

FORM APPROVED BY MICHIGAN STATE BOARD OF LAND SURVEYORS, 11/71
REVISED MAY 14, 1975
REVISED JAN., 1983
ADAPTED FOR WORD PROCESSING MARCH, 1993

NOV 26 1997

COMMISSION

