

MAR 02 1999

SECTION

1998 REMONUMENTATION PROGRAM  
LAND CORNER RECORDATION CERTIFICATE  
Filing Requirement of Act 74, Mich. P.A. 1970

RECEIVED FOR RECORD  
LIBER NO. \_\_\_\_\_ PAGE NO. #52  
FILE NO. ELKLAND TWP

98 NOV 20 AM 11:40

*George M. Field*  
TUSCOLA COUNTY  
REGISTER OF DEEDS

For corners in: ELKLAND TWP.

<u>TUSCOLA</u> (County)	Located In:	Corner Code #
1. Public Land Survey	T <u>14N</u> R <u>11E</u>	<u>A-8</u>
	T _____ R _____	_____
	T _____ R _____	_____
	T _____ R _____	_____
2. Property Controlling in Section	S _____ T _____ R _____	_____
	S _____ T _____ R _____	_____
3. Miscellaneous Property in Sec.	S _____ T _____ R _____	_____
	S _____ T _____ R _____	_____

Register of Deeds Stamp & File Number

4. Lot No. \_\_\_\_\_ Recorded Plat \_\_\_\_\_  
5. Private Claims \_\_\_\_\_

I, JONATHAN M. FIELD, in a field survey on MAY 15 1998,  
do hereby certify that under requirements of P.A. 74, Michigan P.A. of 1970, the corner points mentioned  
in lines 1 and 2 above were in conformance with regulations and rules therefore as required in the  
current manual of survey instructions of the United States Department of the Interior, Bureau of Land  
Management or by a decree of a Court of Law and/or that the corner points mentioned in lines 3, 4 and 5  
above were in conformance with the rules of the Michigan Board of Land Surveyors or by a Decree of a  
Court of Law; established, re-established, monumented, re-monumented, recovered, found as  
expressed below:

NOTE: Not more than 4 corners, all in the same town and range, may be recorded  
on this certificate.

	A	B	C	D	E	F	G	H	I	J	K	L	M
1													
2	6	5	4	3	2	1							
3													
4	7	8	9	10	11	12							
5													
6	18	17	16	15	14	13							
7													
8	19	20	21	22	23	24							
9													
10	30	29	28	27	26	25							
11													
12	31	32	33	34	35	36							
13													

A. Description of original monument and accessories and/or subsequent restoration:

1835 GLO; PARKE D.S.; SET AS M-8 T14N-R10E; 1/4 SEC. POST; LYNN 14 S8W 43 LKS., BEECH 5 N26W 1 LKS.  
1975 ROWE ENG.; BECK, P.S.# 21559; SURVEY L.453 PG.45; 1/2" RE-ROD; S15°W 97.36' PK NAIL IN P/P; S80°E 33.03'  
W. FACE POST FOR UNDER GROUND TEL. CABLE, N15°W 143.68' RLS 11192 TAG IN P/P; EAST 3' +/- C/L  
ROAD.  
1975 BECK, P.S.#21559; LCRC PG.17; FND 3/4" RE-ROD; SAME WITS AS 1975 ROWE ENG. SURVEY CITED ABOVE.  
1983 BOLDT, P.S.#28405; LCRC PG.28; FND 1/2" RE-ROD; S15°W 97.35' FND PK IN NE FACE P/P, N15°W 143.74' FND  
NAIL W/ REI TAG IN P/P, S85°E 33.08' W FACE OF CABLE ROUTE POST, EAST 3.0' PHYS. C/L ASPHALT

GLO NOTES FOR T14N-R11E IMPLY THAT THIS CORNER IS COMMON WITH M-8 T14N-R10E

B. Description of corner evidence found and/or method applied in restoring or reestablishing corner:

1998 ROWE; FIELD, PS #37276; FND. 1/2" ROD 3' W. OF C/L ASPH. ROAD N-S & IN LINE W/ TREE ROW E-W.  
RECOVERED 4 PREVIOUS WITS. WHICH INDICATE THAT FND. ROD IS IN SAME POSITION AS 1975 SURVEY  
CITED IN SECTION A ABOVE.

ACCEPTED FND. ROD AS A CAREFUL & FAITHFUL PERPETUATION OF THE ORIGINAL CORNER POSITION

C. Description of monument for corner and accessories established to perpetuate locating the position of the corner:

A-8 REPLACED FND 1/2" ROD W/ STD. REMON. MONUMENT & CAP STAMPED M 8 T14N R10E IN MON. BOX  
S12°W, 97.23' FND. P-K NAIL IN NE FACE P.POLE  
N08°W, 143.74' FND. NAIL W/ TAG #11192 IN SE FACE P.POLE  
N56°E, 19.51' SET 1/2" ROD W/ CAP #37276  
S38°E, 27.07' SET 1/2" ROD W/ CAP #37276  
S85°E, 33.06' W. FACE OF UNDERGROUND CABLE MARKER POST  
S84°W, 51.94' SET NAIL W/ TAG #37276 IN S. FACE 5" ELM




Signed by *Jonathan M. Field*  
Surveyor's Michigan License No. 37276

Date 11-2-98

APPROVED  
10-19-98  
*1600  
JMF  
MSB*

FORM APPROVED BY MICHIGAN STATE BOARD OF LAND SURVEYORS, JAN. 28, 1971  
REVISED MAY 14, 1978  
REVISED JAN. 1983  
ADAPTED FOR WORD PROCESSING MARCH, 1993

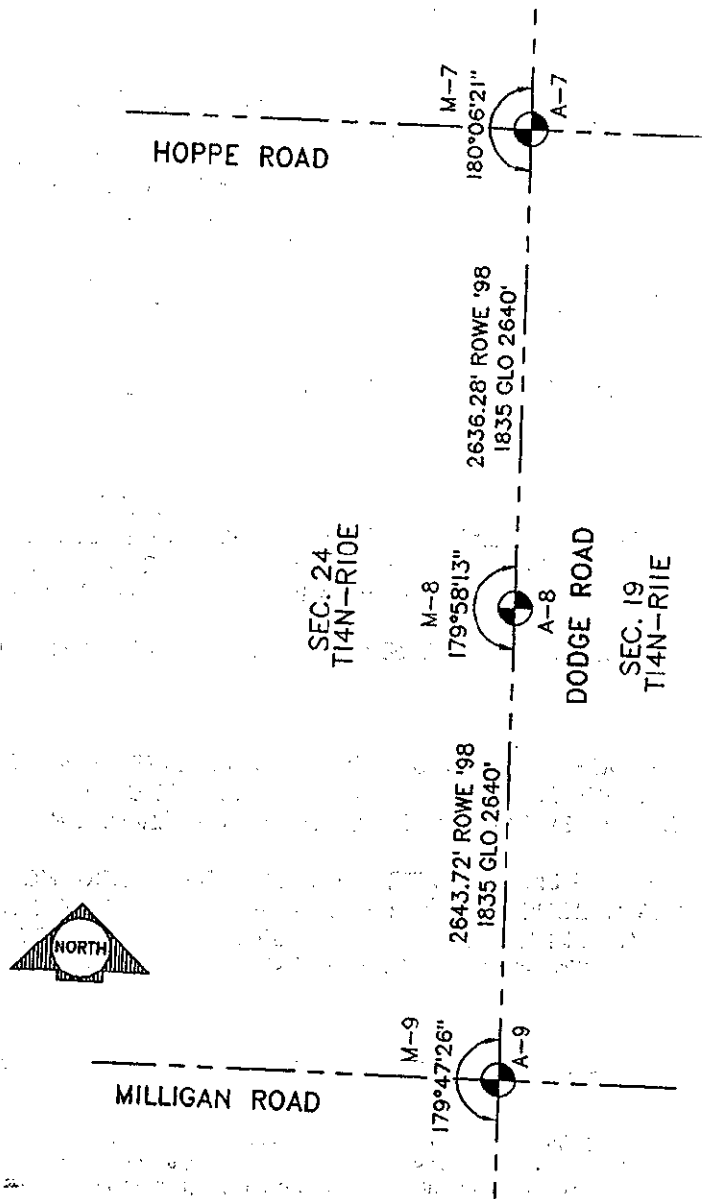

SURVEY &  
REMONUMENTATION

MAR 02 1999

SECTION