

1996 REMONUMENTATION PROGRAM  
LAND CORNER RECORDATION CERTIFICATE  
Filing Requirement of Act 74, Mich. P.A. 1970

RECEIVED FOR RECORD  
LIBER NO. \_\_\_\_\_ PAGE NO. 38  
FILE NO. N. Akron

96 DEC 10 AM 8:55

*Jonathan M. Field*  
TUSCOLA COUNTY  
REGISTER OF DEEDS

Register of Deeds Stamp & File Number

For corners in N. AKRON TWP.  
TUSCOLA  
(County)

Located In:

Corner Code #

1. Public Land Survey T 15N R 08E  
T \_\_\_\_\_ R \_\_\_\_\_  
T \_\_\_\_\_ R \_\_\_\_\_  
T 15N R 7E  
2. Property Controlling S \_\_\_\_\_ T \_\_\_\_\_ R \_\_\_\_\_  
in Section S \_\_\_\_\_ T \_\_\_\_\_ R \_\_\_\_\_  
3. Miscellaneous S \_\_\_\_\_ T \_\_\_\_\_ R \_\_\_\_\_  
Property in Sec. S \_\_\_\_\_ T \_\_\_\_\_ R \_\_\_\_\_

MEANDER COR.  
WIT. MON. 0002

#0002

4. Lot No. \_\_\_\_\_, Recorded Plat \_\_\_\_\_  
5. Private Claims \_\_\_\_\_

I, JONATHAN M. FIELD, in a field survey on MAY 21 19 96, do hereby certify that under requirements of P.A. 74, Michigan P.A. of 1970, the corner points mentioned in lines 1 and 2 above were in conformance with regulations and rules therefore as required in the current manual of survey instructions of the United States Department of the Interior, Bureau of Land Management or by a decree of a Court of Law and/or that the corner points mentioned in lines 3, 4 and 5 above were in conformance with the rules of the Michigan Board of Land Surveyors or by a Decree of a Court of Law; established, re-established, monumented, re-monumented, recovered, found as expressed below:

NOTE: Not more than 4 corners, all in the same town and range, may be recorded on this certificate.

	A	B	C	D	E	F	G	H	I	J	K	L	M
1													
2	6	5	4	3	2	1							
3													
4	7	8	9	10	11	12							
5													
6	18	17	16	15	14	13							
7													
8	19	20	21	22	23	24							
9													
10	30	29	28	27	26	25							
11													
12	31	32	33	34	35	36							
13													

- A. Description of original monument and accessories and/or subsequent restoration:  
1834 GLO; RISDON, D.S.; SET POST ON BANK OF SAGINAW BAY @ 52.86CH; W. OAK 12 S46W 17L, LYNN 10 N46E 43L.  
1867 CRANSTON, C.S.; NOTED 12.50 CHAINS TO SAG. BAY FROM 1/4 POST TO SOUTH  
1870 CRANSTON, C.S.; SURVEY IN SEC.31 T15N-R8E; MEANDER CORNER NOT SHOWN; NO DIST'S., NO WITS  
1902 FELTON, C.S.; SURVEY IN SEC.36 T15N-R7E; POST AT CORNER; NO WITS GIVEN; DIST. OF 12.32 CH. FROM 1/4 POST TO SOUTH  
1956 R.J. BLACK, RLS #3384; CENZER'S SUBDIVISION; L.2 OF PLATS, PG.21; W. LINE OF PLAT FROM SW CORNER OF PLAT TO 170' N. RUNS PARALLEL WITH W. LINE OF SEC.31 T15N-R8E; W 1/4 COR. SHOWN 500.0' SOUTH OF PLAT  
1985 UNRECORDED SURVEY BY EDMANDS ENGINEERING FOR WILLIAM MC ALPINE JOB NO. EMS 2262.01 DATED 10-85; APPEARS TO HAVE HELD SECTION LINE PER PLAT OF CENZER'S SUBDIVISION BEING 33' W'LY OF FND. CONC. MONUMENT AT SW CORNER OF LOT 1; W 1/4 COR. SHOWN 549.93' SOUTH OF PLAT
- B. Description of corner evidence found and/or method applied in restoring or reestablishing corner:  
1996 ROWE ENG.; FIELD, P.S.#37276; POSITION NOW FALLS IN SAGINAW BAY; NEITHER 1956 PLAT NOR 1985 SURVEY CITED IN SECTION A. ABOVE INDICATE POSITION OF MEANDER CORNER; CORNER IS INACCESSABLE; ACCEPTED POSITION OF TOWNSHIP LINE PER 1985 SURVEY CITED ABOVE BEING 33' W'LY OF THE MONUMENTED SW'LY CORNER OF LOT 1 OF CENZER'S SUBDIVISION

SET WITNESS MONUMENT TO TOWNSHIP LINE (SEE SKETCH ON BACK OF THIS FORM)

- C. Description of monument for corner and accessories established to perpetuate locating the position of the corner: 0001  
SET WITNESS MONUMENT TO TOWNSHIP LINE; SET STANDARD REMON MONUMENT STAMPED "WIT. MON. T15N R7E" 33.00' WESTERLY OF FOUND CONC. MONUMENT AT SW CORNER OF LOT 1 CENZER'S SUBDIVISION & ON S. LINE OF LOT 1 EXTENDED TO WEST. WITNESSES ARE TO WITNESS MONUMENT NOT MEANDER CORNER;

EAST, 33.00' FND. CONC. MON. AT SW CORNER LOT 1 CENZER'S SUBDIVISION  
N58°E, 83.80' SET P-K NAIL W/TAG #37276 IN NW FACE P.POLE  
S68°E, 72.84' SET P-K NAIL W/TAG #37276 IN SW FACE P.POLE  
S13°W, 77.49' SET NAIL W/TAG #37276 IN SE FACE 12" POPLAR

NOTE: ORIGINAL MEANDER CORNER COMMON TO T15N-R7E & T15N-R8E


Signed by *Jonathan M. Field*

Date 12-4-96

Surveyor's Michigan License No. 37276

APPROVED  
12-2-96  
*K.B.G.*  
*R.C.B.*

FORM APPROVED BY MICHIGAN STATE BOARD OF LAND SURVEYORS, JANUARY 1993  
ADAPTED FOR WORD PROCESSING MARCH 1993

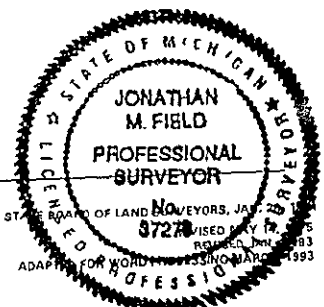

MAY 20 1997

20

SAGINAW BAY

MEANDER  
CORNER

INACCESSIBLE  
NOT SET



1902 FELTON 813.12'  
1870 CRANSTON 825'  
1834 GLO 848.76'

SOUTHCATE OUTLET DRAIN

CENZER'S SUBDIVISION  
L. 2 OF PLATS PG. 21

LOT 1

