

FILED

# LAND CORNER RECORDATION CERTIFICATE FILING REQUIREMENT OF ACT 74, MICH. P.A. 1970

Dec 16 9 19 AM '99

W 1/4 Post, Sec 22, South Haven Twp.

FOR CORNERS OF:

LOCATED IN:

CORNER CODE NUMBER

1. PUBLIC LAND SURVEY, T. 1 S., R. 17 W.

G-8

2. PROPERTY CONTROLLING IN SECTION, T. N. S., R. E. W.

3. MISCELLANEOUS PROPERTY IN SECTION, T. N. S., R. E. W.

4. LOT NO. RECORDED PLA

5. PRIVATE CLAIMS

DEC 28 1999

SECTION

REGISTER OF DEEDS STAMP  
AND FILING NUMBER

I, Charles D. Lossie, in a field survey on 13-Dec, 1999 do hereby state that under requirements of P.A. 74, Michigan P.A. of 1970, the corner points mentioned in lines 1 and 2 above were in conformance with regulations and rules therefore as required in the current manual of survey instructions of the United States Department of the Interior, Bureau of Land Management or by a decree of a Court of Law and/or that the corner points mentioned in lines 3, 4 and 5 above were in conformance with the rules of the Michigan Board of Land Surveyors or by a Decree of a Court of Law; established, re-established, monumented, recovered, found as expressed below:

NOTE: Not More than 2 corners, all in the same town and range may be recorded on this certificate.

	A	B	C	D	E	F	G	H	I	J	K	L	M
1													
2	6	5	4	3	2	1							
3													
4	7	8	9	10	11	12							
5													
6	18	17	16	15	14	13							
7													
8	19	20	21	22	23	24							
9													
10	30	29	28	27	26	25							
11													
12	31	32	33	34	35	36							
13													

A. Description of original monument and accessories and/or subsequent restoration:

4/1830- GOVERNMENT - R. Clark, Jr., D.S.

Ran North between Sections 21 and 22 a distance of 40.00 chs. (2640.00') and set Quarter Section Post.

Witnesses:

6" Sycamore - S. 65° W., 16 lks. (10.56').

7" Hemlock - S. 77° E., 14 lks. (9.24').

See Back Sheet for additional History

B. Description of corner evidence found and/or method applied in restoring or re-establishing corner:

Found 1" square iron pin set in ring of stones and title. This position of the Government Monument was accepted and restored with the approval of the Van Buren County Remonumentation Peer Group of Surveyor's meeting held on 6/30/99 as the best available evidence of the position of the original corner.

Ratified by Peer Group in  
accordance with P.A. 345 of 1990  
Van Buren County Surveyor

Date 12-16-99 D. R. St.

C. Description of monument for corner and accessories established to perpetuate locating the position of the corner:

Set slim line Harrison Marker in Monument Box at the position of found 1" square iron pin.

Power Pole- S. 80° W., 77.75' to PK and Washer.

Top nut on fire hyd., S. 30° W., 64.74'


Power Pole- S. 65° E., 66.06' to PK and Washer.

Power Pole - N. 75° E., 61.77' to PK and Washer.

Signed by

Charles D. Lossie

CHARLES D. LOSSIE, P.S.

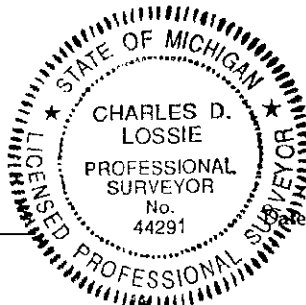

12/15/99

Surveyor's Michigan License No.

44291

FORM APPROVED BY MICHIGAN STATE BOARD OF PROFESSIONAL SURVEYORS,

JAN. 28, 1971

REVISED

MAY. 5, 1975

REVISED

JAN., 1983

REVISED

OCT., 1996

8751 12/16 0104 10SURVEY

9-00

Liber 5 pg. 274

Liber 5 pg 275

**West Quarter Post, Sec 22,  
Town 1 South, Range 17 West, South Haven Twp (G-8)**

**4/13/1871 - A.J. PIERCE, C.S.**

Section 22. Red Book & Book 4 - Page 61.

Quarter Post OK - stake present - renewed large - ran both Quarter lines - set center Quarter Post correctly.  
Distance North is 39.63 chs. (2615.58').

**12/13/1891 - F.P. LAWTON, C.S.**

Section 21 - Book 6 - Page 39

Found stake.

**7/14/1904 - W. H. GOSS, C.S.**

Section 21. Red Book & Goss Notes

Iron and stone.

*Witnesses:*

Sugar - SE 52 lks (34.32').

T. Pole - NW., 75 lks. (49.50').

T. Pole - W., 70.66 lks. (46.64').

DEC 28 1999

SECTION

**7/14/1923 - T.A. SMITH, C.S.**

Section 21. Red Book

Found butts of old poles. Found single iron bar with top flush with paving.

*Witnesses:*

8" Maple - S. 45° E., 34.6' to Centerline.

New T. Pole - N. 30° W., 46.2' to near edge.

New T. Pole - N. 06° W., 44.15' to near edge.

New T. Pole Brace - S. 40° W., 35.6'.

15" Elm - S. 35° E., 65.3' to Centerline.

Distance West is 1311.30' and continuing West 1311.3' to Center Quarter Post for a total of 2622.60'.

Distance South is 2627.40' to Southeast Corner Section.

Distance East is 1318.80' and continuing East 1318.80' to Center Quarter Post of Section.

Distance North is 2620.00'.

**1931 - M.D.O.T. MAP**

Shows corner 118.15' to Centerline U.S. 31 Hwy. (Spike).

**8/8/1952 - W.Q. SMITH, C.S.**

Section 21

Drawing shows Quarter Post

Distance West is 1311.30'.

8/3/1954 - Drawing shows corner.

Distance West to Centerline U.S. 31 Hwy., is 118.15'.

Distance West to Eighth Post is 1311.30'.

**11/1959 - M.S.H.D. (JOHN L. CORBIT, SURVEY CHIEF).**

Section 22

Railroad spike.

*Witnesses:*

Tel. Pole - S. 35° W., 40.94'.

31" Elm - S. 25° E., 65.17'.

P.Pole - N. 60° E., 61.60'.

**7/27/1973 - G.J. MITCHELL, R.L.S.(ALPHA ENG.)**

Section 21.

Recorded Survey (Liber 4 - Page 80).

Shows Corner.

*Witnesses:*

Street Sign - N. 45° E., 38.95'.

Tele. Cable Box - S. 45° E., 40.75'.

Power Pole - S. 45° E., 40.75'.

8/30/1973 - Recorded Survey (Liber 4 - Page 92).

Shows corner and witnesses same as above.

Distance West is 2623.00'.

8/30/1973 - Recorded Certificate (Liber 2 - Page 111).

Found iron - witnesses same as above.

6/29/1977 - Recorded Certificate (Liber 2 - Page 482).

Found iron - witnesses same as above.

**3/22/1983 - J.C. HUNT, R.L.S.**

Section 21

Drawing shows corner.

**7/18/1996 - G. W. Mitchell, P.S.**

Section 22

Found 1" single iron in monument box with witnesses the same as above.

2/2/1998 - Drawing shows corner and witnesses same as above.