

SURVEY &
REMONUMENTATION

APR 25 1995

COMMISSION

LAND CORNER RECORDATION CERTIFICATE

Filing Requirement of Act 74, Mich. P.A. 1970

For corners in Waverly Township

Van Buren County

(County)

Located In:

Corner Code ##

1. Public Land Survey T 2S R 14W F-5
South 1/4 Post, Sec. T 9 R
T R
T R
2. Property Controlling S T R
in Section S T R
3. Miscellaneous S T R
Property in Sec. S T R
4. Lot No. , Recorded Plat
5. Private Claims

DEC 27 9 26 AM '94

Mark A. Smith
VAN BUREN CO.
REGISTERED DEEDS

LIBER 4 PAGE 245

Register of Deeds Stamp & File Number

9.00

12/27 0101 10SURVEY 9459

I, Donald R. Gilchrist survey on December 22, 1994
do hereby certify that under requirements of P.A. 74, Michigan P.A. of 1970, the corner points mentioned
in lines 1 and 2 above were in conformance with regulations and rules therefore as required in the
current manual of survey instructions of the United States Department of the Interior, Bureau of Land
Management or by a decree of a Court of Law and/or that the corner points mentioned in lines 3, 4 and 5
above were in conformance with the rules of the Michigan Board of Land Surveyors or by a Decree of a
Court of Law; established, re-established, monumented, re-monumented, recovered, found as
expressed below:

NOTE: Not more than 4 corners, all in the same town and range, may be recorded
on this certificate.

A. Description of original monument and accessories and/or subsequent restoration:

See Reverse

B. Description of corner evidence found and/or method applied in restoring or reestablishing corner:

Newly Paved Road - M.D.O.T. replaced railroad spike with 1" iron bar in
monument box. Pulled bar and set slim line Harrison Marker.


Approved at the November 30, 1994 Van Buren County Peer Group Meeting and
is accepted as a careful and faithful re-establishment of the position of
the Original Government Corner.

Ratified by Peer Group in
accordance with P.A. 345 of 1998
Van Buren County Surveyor

Date 12/27/94 D. R. A.

C. Description of monument for corner and accessories established to perpetuate locating the position of the corner:

Slim line Harrison Marker in monument box
10" Ash - S.29°33' E. - 61.60'
6" Ash - S.30°33' W. - 58.55'
Wood post N.13°10' W. - 95.78'
6" Ash N.30°E. - 68.49' on centerline of M-43.

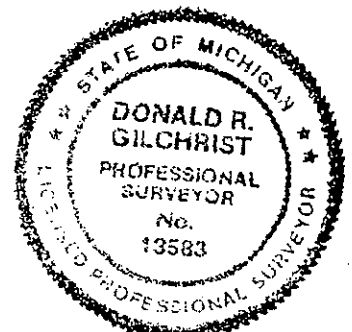

Signed by

Donald R. Gilchrist

Date

12/27/94

Surveyor's Michigan License No.

Donald R. Gilchrist, RLS #13583

FORM APPROVED BY MICHIGAN STATE BOARD OF LAND SURVEYORS, JAN. 28, 1971
REVISED MAY 14, 1975
REVISED JAN 1983

SOUTH QUARTER POST OF SECTION 9,
TOWN 2 SOUTH, RANGE 14 WEST, WAVERLY TOWNSHIP.

4/1830 - GOVERNMENT - G. W. Harrison, D.S.

East between Sections 9 & 16 a distance of 79.75 chs. (5263.5').

Set Quarter Section Post at 39.875 chs. (2631.75').

Witnesses:

14" White Ash - S. 71 Deg. W. - 18 lks. (11.88').

10" Elm - N. 42 Deg. W. 27 lks. (17.82').

1949 - M.D.O.T. Right of Way Map.

Shows no corner.

10/20/1949 - T. A. Smith, C.S.

Drawing shows corner (Note shows "set spike").

Distance West of 1330' (plus or minus) to occupation.

Field note shows 2660' West to Southwest Corner of Section.

3/18/1954 - J. Stack, R.L.S. (W. Q. Smith, C.S.).

Field Note shows corner.

2/25/1975 - D. R. Gilchrist, C.S.

Recorded Survey (Liber 5 - Page 274).

Found Railroad Spike in Center Line of M-43 Highway.

Witnesses:

Telephone Pole - N. 15 Deg. W. - 95.85' to nail.

Fence Corner Post - S. 58.60' to nail.

Corner in Center Line of Road to North.

Street Sign Post - N. 20 Deg. E. - 39.26' to Center Line.