

NOV 15 1994

FILED

LIBER 4 PAGE 173

LAND CORNER RECORDATION CERTIFICATE  
Filing Requirement of Act 74, Mich. P.A. 1970

OCT 18 12 03 PM '94

For corners in Paw Paw Township

Van Buren County  
(County)

Located In:

Corner Code ##

Mark A. Smith  
VAN BUREN CO.  
REGISTERED PROFESSIONAL

1. Public Land Survey T 3S R 14W I-5  
NE Cor. Sec. 15 T R  
T R  
T R
2. Property Controlling S T R  
in Section S T R
3. Miscellaneous S T R  
Property in Sec. S T R

4. Lot No. , Recorded Plat  
5. Private Claims

Date S. R. A. 10/18/94

June 29, 1994

I, Donald R. Gilchrist, in a field survey on June 29, 1994, do hereby certify that under requirements of P.A. 74, Michigan P.A. of 1970, the corner points mentioned in lines 1 and 2 above were in conformance with regulations and rules therefore as required in the current manual of survey instructions of the United States Department of the Interior, Bureau of Land Management or by a decree of a Court of Law and/or that the corner points mentioned in lines 3, 4 and 5 above were in conformance with the rules of the Michigan Board of Land Surveyors or by a Decree of a Court of Law; established, re-established, monumented, re-monumented, recovered, found as expressed below:

NOTE: Not more than 4 corners, all in the same town and range, may be recorded on this certificate.

## A. Description of original monument and accessories and/or subsequent restoration:

Government Witness: W Oak 10" S 33° W 75 links  
W Oak 18" N 23° E 80 links.

On 8/5/85 D. Gilchrist fd. iron & cap #10707 in 1" pipe lying on top of bank at drive to Township Compactor. He dug down in edge of bank 4'± & fd. crockery, china & ½" iron. A.J. Pierce 3/28/1871 reset stake & stone in old orchard. Geo. Mutchler 11/29/1899 fd. stone & remains of Pierce wit. 5/15/1900 Mutchler fd. stone. In about 1900 W.H. Goss fd. stone. 1/2/29 T.A. Smith fd. I.P. 3" below surface per Goss wit. & 10/9/46 again fd. pipe. In about 1970 J. Stack fd. pipe & set iron & cap in pipe.

(continued on back of Certificate)


## B. Description of corner evidence found and/or method applied in restoring or reestablishing corner:

Fd. iron & cap #13583 at bottom of bank at drive to Township Compactor as per D. Gilchrist survey #85.404/85.143 rec. in L 009 on page 114 of Surveys. (D.R. Gilchrist had fd. iron & cap #10707 in 1" pipe lying on top of bank at drive to Paw Paw Township Compactor. He dug down at W edge of bank 4'± and fd. crockery, china and ½" iron. He set iron over with his cap #13583. He wit: P.P. SSW 4.55' to 60d spike E side; P.P. N 45° W 57.64' to 60d spike NE side; fd. edge of asphalt paving W 5.27'; and 267.5' N of C/L of Red Arrow Hwy. This corner approved for remonumentation at meeting of Peer Group on 7/29/92 and recorded in Liber 3 on Page 237. On 7/30/92 fd. corner as stated above. Set Standard Harrison Marker 6" below grade on W. edge of drive to Paw Paw Township Compactor. Corner at E base of 4' high bank. Replaced broken crockery & china around marker. Also set

(Continued on back of Certificate)

## C. Description of monument for corner and accessories established to perpetuate locating the position of the corner:

Found iron with cap #13583 (See above).  
SSW 4.55' 60d spike in E side of power pole  
N 45° W 57.64' 60d spike in NEly side power pole  
W 5.27' E edge of asphalt paving  
Red Arrow Hwy. C/L 267.5' South  
SSW 4.00' set witness marker near NE face pole

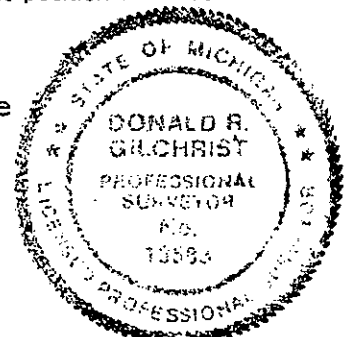

Signed by

Donald R. Gilchrist

Date

9/22/94

Surveyor's Michigan License No. Donald R. Gilchrist, RLS #13583

LINER 4 PAGE 174

A. Continued from front of Certificate:

On 7/18/78 W.Q. Smith fd. iron & cap #10707 in pipe; N of C/L Red Arrow Hwy. by 267.5'; 60d spike E. side P.P. SSW 4.73'; corner 5.5'± E of E edge of asphalt paving at exit lane from Paw Paw Township Compactor. D. Gilchrist fd. 8/5/85 & 11/15/91.

B. Continued from front of Certificate:

Witness Marker: SSW 4.00' set Witness Marker near NE face pole. Corner field check by D.R. Gilchrist, County Surveyor, on 6/22/94. Approved at the 6/29/94 Van Buren County Peer Group Meeting and is accepted as a careful and faithful perpetuation of the position of the Original Government Corner.