

1993

## COMMISSION

LAND CORNER RECORDATION CERTIFICATE  
Filing Requirement of Act 74, Mich. P.A. 1970

SEP 23 8 37 AM '93

For corners in  
Lawrence Township  
Van Buren County  
(County)

Located In:

Corner Code ##

Mark A Smith  
VAN BUREN CO  
REGISTERED DEEDS

1. Public Land Survey T 3S R 15W E-13  
SW corner Section 33 T \_\_\_\_\_ R \_\_\_\_\_  
T \_\_\_\_\_ R \_\_\_\_\_  
T \_\_\_\_\_ R \_\_\_\_\_  
T \_\_\_\_\_ R \_\_\_\_\_

2. Property Controlling S \_\_\_\_\_ T \_\_\_\_\_ R \_\_\_\_\_  
in Section S \_\_\_\_\_ T \_\_\_\_\_ R \_\_\_\_\_  
S \_\_\_\_\_ T \_\_\_\_\_ R \_\_\_\_\_

3. Miscellaneous S \_\_\_\_\_ T \_\_\_\_\_ R \_\_\_\_\_  
Property in Sec. S \_\_\_\_\_ T \_\_\_\_\_ R \_\_\_\_\_

Register of Deeds Stamp &amp; File Number

4. Lot No. \_\_\_\_\_, Recorded Plat \_\_\_\_\_  
5. Private Claims \_\_\_\_\_

I, Donald R. Gilchrist in a field survey on July 26, 19 93,  
do hereby certify that under requirements of P.A. 74, Michigan P.A. of 1970, the corner points mentioned  
in lines 1 and 2 above were in conformance with regulations and rules therefore as required in the  
current manual of survey instructions of the United States Department of the Interior, Bureau of Land  
Management or by a decree of a Court of Law and/or that the corner points mentioned in lines 3, 4 and 5  
above were in conformance with the rules of the Michigan Board of Land Surveyors or by a Decree of a  
Court of Law; established, re-established, monumented, re-monumented, recovered, found as  
expressed below:

NOTE: Not more than 4 corners, all in the same town and range, may be recorded  
on this certificate.

## A. Description of original monument and accessories and/or subsequent restoration:

4/1827 - Government - William Brookfield, D.S.

West on South line of Section 33 - 80 ch., set Post Corner

Witnesses - 7" sugar - N 59 Deg 30' E - 12 lks. (7.92')

15" sugar - N 67 Deg W - 54 lks. (35.64')

10/28/1868 - A.J. Pierce

Found old stake - no witnesses

Renewed with stake &amp; stone

Measured North 40.045 ch. (2642.97')

(continued on back of Certificate)

## B. Description of corner evidence found and/or method applied in restoring or reestablishing corner:

Found hollow steel shaft as set by Homer Ward, Co. Rd. Eng. in place  
of the stone

Pulled shaft and set Harrison Marker

This corner accepted as a careful & faithful perpetuation of the  
Section corner

Approved by County Peer Group on 7/28/93

## C. Description of monument for corner and accessories established to perpetuate locating the position of the corner:

Pulled shaft and set Harrison Marker marked "County Surveyor"

36" maple - West - 59.52'

P.P. - South - 109.50'

P.P. - S 45 Deg E - 124.59'

NW corner, Section 4, Hamilton - E - 87.8'

CL dr W - N - 15'+

CL Rd N &amp; S - E - 30'+

P.P. - N 20 Deg E - 121.09'


Survey marker post SW 1'+

Signed by

Donald R. Gilchrist

Surveyor's Michigan License No.

R.L.S. 13583

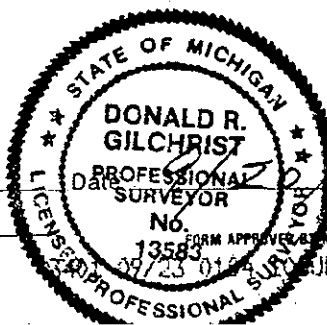

93

FORM APPROVED BY MICHIGAN STATE BOARD OF LAND SURVEYORS, JAN. 28, 197  
REVISED MAY 14, 197  
REVISED JAN., 198

A. Continued from front of Certificate

3/21/1904 - J. S. Haines, C.S.

Found Corner.

Witnesses - 20" Elm - N 86 Deg 30' E - 1.03 ch. ( 67.98').

4" Maple - N 21 Deg 15' E - 1.21 ch. ( 79.86').

1900+- - W. H. Goss, C.S.

Shows Stone.

Same witnesses as above.

7/26/1934 - Homer Ward, County Road Eng.

Found Stone.

Renewed and replaced with hollow steel shaft 6" below surface surrounded with collar of broken stones.

Witnesses - Drive Shaft 2' above surface N 42 Deg E - 48.3'.

40" Elm - N 87 Deg 30'E - 68'.

1" Rod with nut projects 6" above surface located in fence line S 35 Deg E - 49.0'.

7/26/1993 - Don R. Gilchrist, C.S.

Found hollow Shaft with collar of Stones.

All Witnesses gone.

Jog measured to 1 1/2" Shaft 87.37'.