

FEB 28 1994

LAND CORNER RECORDATION CERTIFICATE  
Filing Requirement of Act 74, Mich. P.A. 1970

1126392 PA 849

COMMISSION

For corners in

<u>Wayne</u> (County)	Located In: City of Detroit	Corner Code #
1. Public Land Survey	T <u>1</u> S. R. <u>11</u> E	<u>CG-7</u>
	T _____ R _____	_____
	T _____ R _____	_____
	T _____ R _____	_____
2. Property Controlling in Section	S _____ T _____ R _____	_____
	S _____ T _____ R _____	_____
3. Miscellaneous Property in Sec.	S _____ T _____ R _____	_____
	S _____ T _____ R _____	_____
4. Lot No. _____, Recorded Plat _____		
5. Private Claims _____		

Compliance with  
ACT 345, P.A. 1990

APPROVED ON: 11-18-93 *DBJ*  
WAYNE COUNTY REMONUMENTATION  
PEER GROUP COMMITTEE

Register of Deeds Stamp & File Number

I, Steven E. Dunn, in a field survey on November 8, 19 93, do hereby certify that under requirements of P.A. 74, Michigan P.A. of 1970, the corner points mentioned in lines 1 and 2 above were in conformance with regulations and rules therefore as required in the current manual of survey instructions of the United States Department of the Interior, Bureau of Land Management or by a decree of a Court of Law and/or that the corner points mentioned in lines 3, 4 and 5 above were in conformance with the rules of the Michigan Board of Land Surveyors or by a Decree of a Court of Law; established, re-established, monumented, re-monumented, recovered, found as expressed below:

**NOTE:** Not more than 4 corners, all in the same town and range, may be recorded on this certificate.

A. Description of original monument and accessories and/or subsequent restoration:

GLO - Post, No GLO witnesses remain

GLO Survey done by Joseph Fletcher under contract dated 3 Sep., 1816

B. Description of corner evidence found and/or method applied in restoring or reestablishing corner:

No evidence of corner

Established West R/W line of Schaefer Rd. by found irons, back of walk, and Ex. building lines. Established North and South R/W lines of Fenkell by Fd. irons and back of walk lines. Verified distances. Set corner 33.00' South of N. R/W Fenkell Rd. to West and 33.00 East of West R/W line of Schaefer Rd.

Placed Wayne County Remonumentation marker and plastic cap #38408 on 1/2" X 18" iron within a monument box.

C. Description of monument for corner and accessories established to perpetuate locating the position of the corner:

Wayne County Remonumentation marker and plastic cap #28408 1/2" X 18" iron within a monument box.

Witnesses


- |  |                 |
|--|-----------------|
| - Set P.K. Nail and W.C.R. witness tag on top of concrete curb | S.38°W - 40.57' |
| - Set P.K. Nail and W.C.R. witness tag on top of concrete curb | N.42°W - 39.79' |
| - Set P.K. Nail and W.C.R. witness tag on top of concrete curb | N.44°E - 40.60' |
| - Found City of Detroit control monument in hand hole          | S.44°E - 56.26  |

The selected location is a careful and faithful reestablishment of the position of the original corner

Signed by Steven E. Dunn

Date Nov. 30, 1993

Surveyor's Michigan License No. 28408

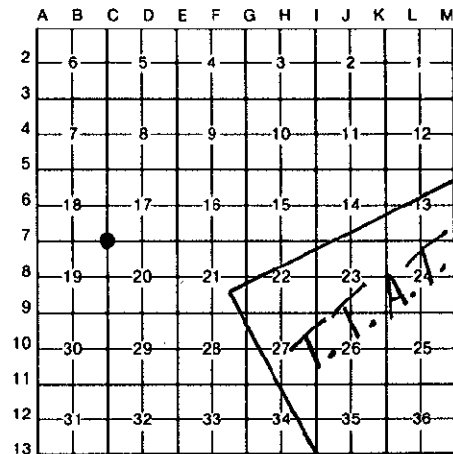

93 NOV 30 PM 4:23  
FOREST E. YOUNGBLOOD  
REGISTER OF DEEDS  
WAYNE COUNTY, MI

20  
11