

LAND CORNER RECORDATION CERTIFICATE  
Filing Requirement of Act 74, Mich. P.A. 1970

For corners in

Wayne  
(County)

Located In:  
City of Detroit

OTHER  
Corner Code ##

1. Public Land Survey T 1 R 12
- T R
- T R
- T R
2. Property Controlling S T R
- in Section S T R
3. Miscellaneous S T R
- Property in Sec. S T R

#1

Compliance with  
ACT 345, P.A. 1990

APPROVED ON: 11-18-93 *DBJ*  
WAYNE COUNTY REMONUMENTATION  
PEER GROUP COMMITTEE


Register of Deeds Stamp & File Number

4. Lot No. , Recorded Plat
5. Private Claims Point common to PC/15 & PC/18 @ E Gratiot and Mt. Elliott

I, Martin C. Dunn, in a field survey on November 6, 19 93, do hereby certify that under requirements of P.A. 74, Michigan P.A. of 1970, the corner points mentioned in lines 1 and 2 above were in conformance with regulations and rules theretofore as required in the current manual of survey instructions of the United States Department of the Interior, Bureau of Land Management or by a decree of a Court of Law and/or that the corner points mentioned in lines 3, 4 and 5 above were in conformance with the rules of the Michigan Board of Land Surveyors or by a Decree of a Court of Law, established, re-established, monumented, re-monumented, recovered, found as expressed below:

NOTE: Not more than 4 corners, all in the same town and range, may be recorded on this certificate.

- A. Description of original monument and accessories and/or subsequent restoration:  
No previously recorded corner set at this location

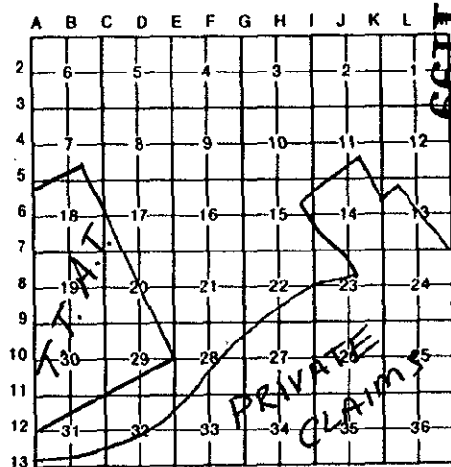

- B. Description of corner evidence found and/or method applied in restoring or reestablishing corner:  
Found City of Detroit monument as accepted by the City of Detroit Survey Bureau  
Verified record dimensions on City of Detroit Engineering Office drawing # S-455  
(dated Nov. 1968)  
Placed Wayne County Remonumentation stamp on existing brass disc over concrete monument in monument box

93 NOV 30 PM 4:25  
FOREST COUNTY, MI  
REGISTER OF DEEDS  
WAYNE COUNTY, MI

- C. Description of monument for corner and accessories established to perpetuate locating the position of the corner:  
Wayne County Remonumentation stamp on existing brass disc over concrete monument in monument box

Witnesses

- Set Masonry Nail with W.C.R. tag in walk @ SW cor. Gratiot and Mt. Elliott 5.52 to centerline 182° AZ - 115.83'
- sanitary manhole and 5.9" to centerline light pole
- Set Masonry Nail with W.C.R. tag in walk @ NW cor. Gratiot and Mt. Elliott 6.4' to centerline 291° AZ - 53.93'
- light pole and 13.5' to centerline P/C manhole
- Set Masonry Nail with W.C.R. tag in walk @ NE cor. Gratiot and Mt. Elliott 5.85' to P/C 0° AZ - 107.97'
- manhole and 8.45' to cor. of Pawn Shop #6301 Gratiot
- Set Masonry Nail with W.C.R. tag in walk @ SE cor. Gratiot and Mt. Elliott 16.55 to Hyd. 121° AZ - 56.70'
- and 14.35 to Light pole

The selected location for this Property Controlling Monument is accepted as a careful and faithful determination of the position as indicated

Signed by Martin C. Dunn

Date 11/17/93

Surveyor's Michigan License No. 30081