

RC 1194

STATE

LAND CORNER RECORDATION CERTIFICATE  
Filing Requirement of Act 74, Mich. P.A. 1970

LI 26992 PA 881

For corners in

Wayne

(County)

Located in:

City of Detroit

OTHER

Corner Code ##

1. Public Land Survey

T 1 R 12

003

T R

T R

T R

2. Property Controlling  
in Section

S T R

S T R

3. Miscellaneous

S T R

Property in Sec.

S T R

Compliance with  
ACT 345, P.A. 1990APPROVED ON: 11-18-93 *DBL*  
WAYNE COUNTY REMONUMENTATION  
PEER GROUP COMMITTEE

Register of Deeds Stamp &amp; File Number



4. Lot No. , Recorded Plat

5. Private Claims Pt. Common to West Line PC/1 and S line Vernor Highway

I, Martin C. Dunn, in a field survey on October 26, 19 93, do hereby certify that under requirements of P.A. 74, Michigan P.A. of 1970, the corner points mentioned in lines 1 and 2 above were in conformance with regulations and rules therefore as required in the current manual of survey instructions of the United States Department of the Interior, Bureau of Land Management or by a decree of a Court of Law and/or that the corner points mentioned in lines 3, 4 and 5 above were in conformance with the rules of the Michigan Board of Land Surveyors or by a Decree of a Court of Law; established, re-established, monumented, re-monumented, recovered, found as expressed below:

NOTE: Not more than 4 corners, all in the same town and range, may be recorded on this certificate.

A. Description of original monument and accessories and/or subsequent restoration:  
Corner not set in original government survey

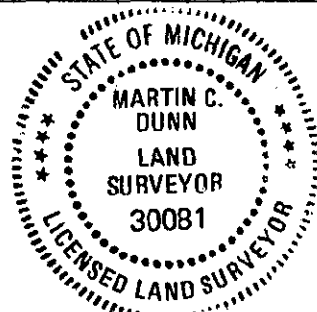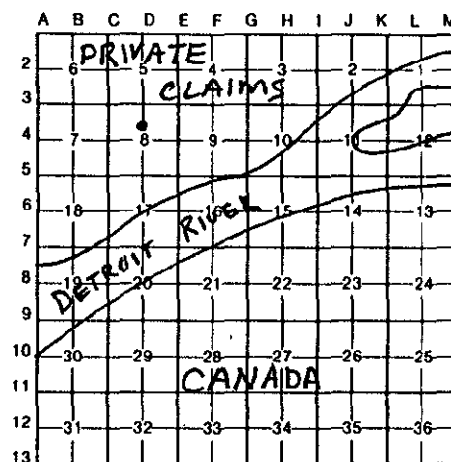

B. Description of corner evidence found and/or method applied in restoring or reestablishing corner:

No evidence of corner

Found stone curb to establish centerline of Brush St.

Found stone curb to establish S. line Vernor Highway

Set corner at record distance from centerline Brush St. along S. line Vernor Highway

(As per Brush subdivision of Park Lot 5 and part of Brush Farm of and adjoining Lots 4 &amp; 5 L. 45 P. 121 (W.C.R.))

C. Description of monument for corner and accessories established to perpetuate locating the position of the corner:

Placed Wayne County Remonumentation marker and plastic cap #30081 on 36" concrete monument

Witnesses

-Set P.K. Nail with W.C.R. tag in wingwall common to Vernor Highway 289° AZ - 78.11'

&amp; I-75

-Set P.K. Nail with W.C.R. tag in wingwall common to Vernor Highway 350° AZ - 80.03'

&amp; I-75

-Set P.K. Nail with W.C.R. tag in sidewalk 64° AZ - 13.27'

-Set P.K. Nail with W.C.R. tap in sidewalk 252° AZ - 6.04

The selected location for this Property Controlling Monument is accepted as a careful and faithful determination of the position as indicated

Signed by

*Martin C. Dunn*

Date

11/17/93

Surveyor's Michigan License No.

30081

RC 1194

30 NOV 30 PM 4:25

RECEIVED  
REGISTER OF DEEDS  
MICHIGAN