

STATE

RC 1195

LI 26992 PA 882

LAND CORNER RECORDATION CERTIFICATE

Filing Requirement of Act 74, Mich. P.A. 1970

For corners in

Wayne
(County)

Located In:

City of Detroit

OTHER

Corner Code #

1. Public Land Survey

T 15 R 12 E

004

T R

T R

T R

2. Property Controlling
in Section

S T R

S T R

3. Miscellaneous

S T R

Property in Sec.

S T R

Compliance with
ACT 345, P.A. 1990APPROVED ON: 11-18-93 DBJ
WAYNE COUNTY REMONUMENTATION
PEER GROUP COMMITTEE

Register of Deeds Stamp & File Number

4. Lot No. , Recorded Plat

5. Private Claims N.W. corner P.C. #1

On Harper between Woodward and Brush

I, Martin C. Dunn, in a field survey on October 14, 1993

do hereby certify that under requirements of P.A. 74, Michigan P.A. of 1970, the corner points mentioned in lines 1 and 2 above were in conformance with regulations and rules therefore as required in the current manual of survey instructions of the United States Department of the Interior, Bureau of Land Management or by a decree of a Court of Law and/or that the corner points mentioned in lines 3, 4 and 5 above were in conformance with the rules of the Michigan Board of Land Surveyors or by a Decree of a Court of Law; established, re-established, monumented, re-monumented, recovered, found as expressed below:

NOTE: Not more than 4 corners, all in the same town and range, may be recorded on this certificate.

A. Description of original monument and accessories and/or subsequent restoration:

GLO Original survey performed by Aaron Greely, Nov 6, 1810

GLO - Post

City of Detroit, engineers Office - Monument with grass disc in monument box

No. S-570, sheets 1 & 2, dated 2/13/76

B. Description of corner evidence found and/or method applied in restoring or reestablishing corner:

Found concrete monument with brass disc in monument box

Verified record dimensions on City of Detroit engineers office drawing No. S-570
Sheet 1 and 2, dated 2/13/76Placed Wayne County remonumentation stamp on existing brass disc over concrete
monument box

C. Description of monument for corner and accessories established to perpetuate locating the position of the corner:

Wayne County remonumentation stamp on existing brass disc over concrete
monument boxWitnesses

- 60 D Nail W. face 28' Maple

223°AZ. - 87.70'

- 60 D Nail N. face 24" Maple

263°AZ. - 95.61'

- 60 D Nail E. face 24" Chestnut

15°AZ. - 32.44'

- P.K. nail in sidewalk 1' N. of NW corner church parking lot

117°AZ. - 62.77'

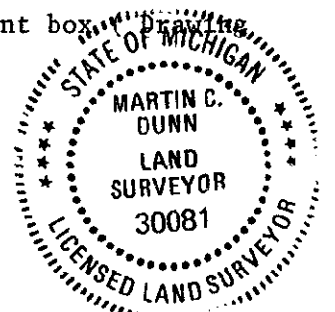
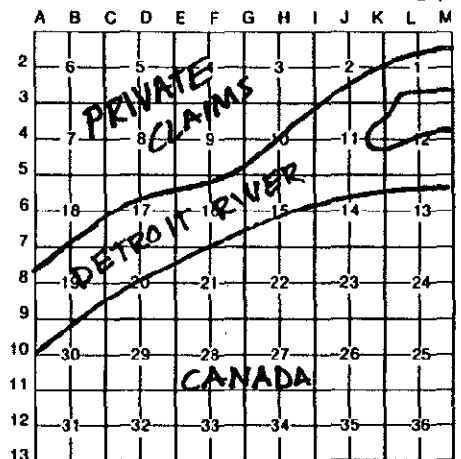
The selected location for this property controlling monument is accepted as a careful
and faithful determination of the position as indicated.

Signed by

Martin C. Dunn

Date 11/17/93

Surveyor's Michigan License No. 30081

FORM APPROVED BY MICHIGAN STATE BOARD OF LAND SURVEYORS, JAN. 28, 1971.
REVISED MAY 14, 1975
REVISED JAN. 1983

NOV 30 PM 4:25
FOREST COUNTY, MI
REGISTER OF DEEDS
WAYNE COUNTY, MI