

LAND CORNER RECORDATION CERTIFICATE
Filing Requirement of Act 74, Mich. P.A. 1970

L127797PA698

For corners in

WAYNE

(County)

Located In:
CITY OF DETROIT

Corner Code #

1. Public Land Survey

T 15 R 12E 006T R T R T R 2. Property Controlling
in SectionS T R S T R 3. Miscellaneous
Property in Sec.S T R S T R 4. Lot No. , Recorded Plat 5. Private Claims 322 NORTHWEST CORNER EAST OF CONNER - SOUTH OF CANFIELDCompliance with
ACT 345, P.A. 1990APPROVED ON: 11-21-94
WAYNE COUNTY REMONUMENTATION
PEER GROUP COMMITTEE

Register of Deeds Stamp & File Number

I, MARTIN C. DUNN, in a field survey on DECEMBER 20, 1994, do hereby certify that under requirements of P.A. 74, Michigan P.A. of 1970, the corner points mentioned in lines 1 and 2 above were in conformance with regulations and rules therefore as required in the current manual of survey instructions of the United States Department of the Interior, Bureau of Land Management or by a decree of a Court of Law and /or that the corner points mentioned in lines 3, 4 and 5 above were in conformance with the rules of the Michigan Board of Land Surveyors or by a Decree of a Court of Law; established, re-established, monumented, re-monumented, recovered, found as expressed below:

NOTE: Not more than 4 corners, all in the same town and range, may be recorded on this certificate.

A. Description of original monument and accessories and/or subsequent restoration:

GLO POST - NO EVIDENCE OF ORIGINAL CORNER FOUND


PRIVATE CLAIMS SURVEYED BY JOSEPH FLETCHER IN 1816

L.C.R.C.

L.26229 P. 314 MARTIN C. DUNN, #30081 SET IRON ROD DECEMBER 15, 1992

PLATS

L. 3 P. 78 DEBUCK'S SUBDIVISION AUGUST 24, 1915

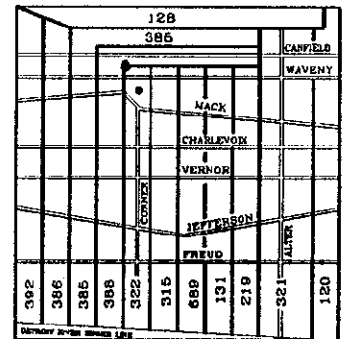

B. Description of corner evidence found and/or method applied in restoring or reestablishing

FOUND 1/2" IRON ROD WITH CAP #30081

VERIFIED LOCATION BY CHECKING FOUND WITNESS TIES OF L.C.R.C.

L.C.R.C.

L. 26229 P. 314	NE	62.70'	FOUND WOODEN LIGHT AND UTILITY POLE
	S. 56° W.	43.64'	FOUND CATCH BASIN
	S. 38° W.	29.23'	FOUND NORTHWEST CORNER OF BUILDING
	S. 73° W.	76.15'	FOUND FIRE HYDRANT

PLACED WAYNE COUNTY REMONUMENTATION MARKER AND ALUMINUM CAP #30081 ON 1/2" x 36" IRON WITHIN A MONUMENT BOX.

\$ 13.00 MISCELLANEOUS RECORDING
 27 DEC 94 10:58 A.M. RECEIPT# 47A
 RECORDED
 FOREST E. YOUNGBLOOD, REGISTER OF DEEDS
 WAYNE COUNTY, MI

C. Description of monument for corner and accessories established to perpetuate locating the position of the corner:

WAYNE COUNTY REMONUMENTATION MARKER AND ALUMINUM CAP #30081 ON 1/2" x 36" IRON WITHIN A MONUMENT BOX.

WITNESSES

AZ. 90°	62.70'	FOUND WOODEN LIGHT AND UTILITY POLE
AZ. 236°	43.64'	FOUND CATCH BASIN
AZ. 218°	29.23'	FOUND NORTHWEST CORNER OF BUILDING
AZ. 253°	76.15'	FOUND FIRE HYDRANT

THE SELECTED LOCATION FOR THIS PROPERTY CONTROLLING MONUMENT IS ACCEPTED AS A CAREFUL AND FAITHFUL DETERMINATION OF THE POSITION AS INDICATED.

Signed by Martin C. Dunn Date 12/22/94Surveyor's Michigan License No. 30081

RC 1535