

LAND CORNER RECORDATION CERTIFICATE
Filing Requirement of Act 74, Mich. P.A. 1970

Li 26992 PA 873

For corners in

Wayne

(County)

Located In:

City of Detroit

OTHER

Corner Code #

1. Public Land Survey

T 1S R 13E# 0001

T _____ R _____

T _____ R _____

T _____ R _____

2. Property Controlling
in Section

S _____ T _____ R _____

S _____ T _____ R _____

3. Miscellaneous
Property in Sec.

S _____ T _____ R _____

Compliance with
ACT 345, P.A. 1990

APPROVED ON: 11-18-93 *DBL*
**WAYNE COUNTY REMONUMENTATION
 PEER GROUP COMMITTEE**

Register of Deeds Stamp & File Number

4. Lot No. _____, Recorded Plat _____

5. Private Claims P.C. corner common to 120 & 570Centerline - Centerline Alter and Charlevoix Rd.I, Steven E. Dunn, in a field survey on November 3, 19 93,

do hereby certify that under requirements of P.A. 74, Michigan P.A. of 1970, the corner points mentioned in lines 1 and 2 above were in conformance with regulations and rules therefore as required in the current manual of survey instructions of the United States Department of the Interior, Bureau of Land Management or by a decree of a Court of Law and/or that the corner points mentioned in lines 3, 4 and 5 above were in conformance with the rules of the Michigan Board of Land Surveyors or by a Decree of a Court of Law; established, re-established, monumented, re-monumented, recovered, found as expressed below:

NOTE: Not more than 4 corners, all in the same town and range, may be recorded on this certificate.

A. Description of original monument and accessories and/or subsequent restoration:
 No GLO Witnesses remain


GLO survey of Private Claims 120 & 570 by Aaron Greeley Jan 4, 1810.

GLO survey of back concessions & intersecting lines. Surveyor unknown. July 1822.

B. Description of corner evidence found and/or method applied in restoring or reestablishing corner:
 Found P.K. and City of Detroit survey marker tag.

Position agrees with adjacent plats and property descriptions.

Placed Wayne County Remonumentation marker and plastic cap #28408 on 18" iron within a monument box.

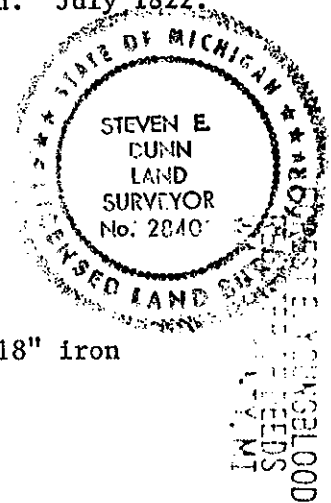

C. Description of monument for corner and accessories established to perpetuate locating the position of the corner:

Wayne County Remonumentation marker and plastic cap #28408 on 18" iron within a monument box
Witnesses

- Set P.K. Nail and W.C.R. witness tag on top of conc. curb	N.27°E - 53.73'
- Set P.K. Nail and W.C.R. witness tag on top of conc. curb	S.69°E - 32.46'
- Set P.K. Nail and W.C.R. witness tag on top of conc. curb	S.10°W - 31.42'
- Set P.K. Nail and W.C.R. witness tag on top of conc. curb	N.82°W - 43.29'

The selected location is a careful and faithful reestablishment of the position of the original corner

Signed by Steven E. DunnDate Nov. 30, 1993Surveyor's Michigan License No. 28408