

RC 1190

LI 26992 PA 877

LAND CORNER RECORDATION CERTIFICATE
Filing Requirement of Act 74, Mich. P.A. 1970

For corners in

Wayne
 (County)

Located In:
 City of Detroit

OTHER
 -Corner Code ##

0005

1. Public Land Survey

T 15 R 13E

T _____ R _____

T _____ R _____

T _____ R _____

2. Property Controlling
in Section

S _____ T _____ R _____

S _____ T _____ R _____

3. Miscellaneous
Property in Sec.

S _____ T _____ R _____

S _____ T _____ R _____

Compliance with
 ACT 345, P.A. 1990

APPROVED ON: 11-18-93 DBJ
 WAYNE COUNTY REMONUMENTATION
 PEER GROUP COMMITTEE

Register of Deeds Stamp & File Number


4. Lot No. _____, Recorded Plat _____

5. Private Claims Point on line between, P.C. 692 & 695N'y R/W of Chandler Park between Whittier and KensingtonI, Steven E. Dunn, in a field survey on November 5, 19 93

do hereby certify that under requirements of P.A. 74, Michigan P.A. of 1970, the corner points mentioned in lines 1 and 2 above were in conformance with regulations and rules therefore as required in the current manual of survey instructions of the United States Department of the Interior, Bureau of Land Management or by a decree of a Court of Law and/or that the corner points mentioned in lines 3, 4 and 5 above were in conformance with the rules of the Michigan Board of Land Surveyors or by a Decree of a Court of Law; established, re-established, monumented, re-monumented, recovered, found as expressed below:

NOTE: Not more than 4 corners, all in the same town and range, may be recorded on this certificate.

A. Description of original monument and accessories and/or subsequent restoration:
 No corner set in original government survey.

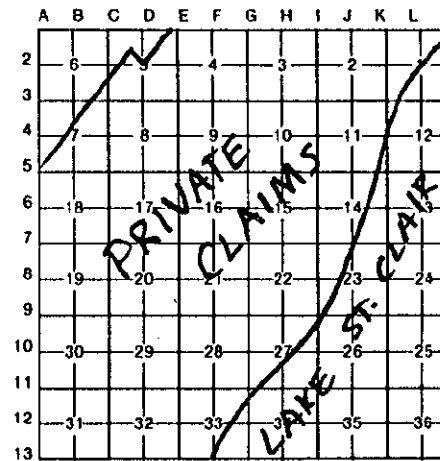

B. Description of corner evidence found and/or method applied in restoring or reestablishing corner:

Fd. 1/2" I. Rod @ North R/W line Chandler Park Drive. Verified location by using found irons with reference to "A.M. Campau's Three Mile Drive Addition Sub'n."

Placed Wayne County Remonumentation and plastic cap #28408 on 36" concrete monument.

33 NOV 30 PM 4:25
 FOREST COUNTY
 REGISTER OF DEEDS
 GRAND RAPIDS, MI

C. Description of monument for corner and accessories established to perpetuate locating the position of the corner:

Wayne County Remonumentation marker and plastic cap #28408 on 36" concrete monument.

Witnesses

- Set P.K. Nail and W.C.R. witness tag in concrete sidewalk S.09°E - 8.30'
- Set P.K. Nail and W.C.R. witness tag in concrete sidewalk N.80°E - 9.27'
- Set P.K. Nail and W.C.R. witness tag in top of concrete curb S.34°E - 57.26'
- Set P.K. Nail and W.C.R. witness tag in top of concrete curb S.30°W - 34.92'

The selected location for this Property Controlling Monument is accepted as a careful and faithful determination of the position as indicated.

Signed by Steven E. DunnDate Nov. 30, 1993Surveyor's Michigan License No. 28408