

FILE DO NOT MAIL

For corners in

LAND CORNER RECORDATION CERTIFICATE
Filing Requirement of Act 74, Mich. P.A. 1970

SECTION

Liber-30803 Page-8
99585631 12/20/1999
F.E. Youngblood, Wayne Co. Register of Deeds
RDANDSYL

Compliance with
ACT 345, P.A. 1990

APPROVED ON: 12-7-99
WAYNE COUNTY REMONUMENTATION
PEER GROUP COMMITTEE

Register of Deeds Stamp & File Number

Wayne Located In: City of Corner Code #
(County) River Rouge

1. Public Land Survey T R
T R
T R
T R

2. Property Controlling S T R
in Section S T R

3. Miscellaneous S T R
Property in Sec. S ~~T~~ R-11-E OTHER CODE
9

T 2 S

4. Lot No. , Recorded Plat

5. Private Claims Intersection of easterly line of P.C. 25 and westerly line of P.C. 525 at the centerline of Byron and Pleasant Avenue.

I, John N. Redash, in a field survey on December 7, 1999 do hereby state that under requirements of P.A. 74, Michigan P.A. of 1970, the corner points mentioned in lines 1 and 2 above were in conformance with regulations and rules therefore as required in the current manual of survey instructions of the United States Department of the Interior, Bureau of Land Management or by a decree of a Court of Law and /or that the corner points mentioned in lines 3, 4 and 5 above were in conformance with the rules of the Michigan Board of Land Surveyors or by a Decree of a Court of Law; established, re-established, monumented, recovered, found as expressed below:

NOTE: Not more than 2 corners, all in the same town and range, may be recorded on this certificate.

A. Description of original monument and accessories and/or subsequent restoration:

Aaron Greeley original Surveyor of Private Claims description 1809.

B. Description of corner evidence found and/or method applied in restoring or reestablishing corner:

No evidence of a corner found. Determined position of point on Private Claim Line 25 and 525 from establishment of monumentation from "Burke's Addition" as recorded in Liber 22, Page 2 and "River Rouge Improvement Company" as recorded in Liber 21, Page 120, Wayne County Records. Supporting documentation and analysis of evidence is available within research dossier on file at Wayne County Register of Deeds.

C. Description of monument for corner and accessories established to perpetuate locating the position of the corner:

I set a 1/2" iron rod with 2" diameter aluminum cap stamped "Wayne County Remonumentation #37281" in a monument box at the centerline of Byron at Pleasant Avenue.

Witnesses are as follows:


AZ 76° 20' 11" 48.37 feet Southwest corner porch foundation of HSE #67.
AZ 07° 51' 53" 35.92 feet Southeast corner foundation HSE # 59.
AZ 333° 17' 49" 29.51 feet Mag nail and W.C.R. Tag northeast face of 18" elm.
AZ 158° 12' 14" 33.14 feet Cut cross on northwest rim of Detroit Edison manhole.

\$4.00 REMONUMENTATION
Receipt #19151

FOREST E. YOUNGBLOOD, REGISTER OF DEEDS
WAYNE COUNTY, MICH.

37281

\$9.00 DEED

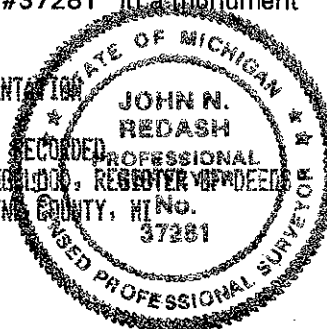

The location of this corner is accepted by myself and is generally accepted by professional surveyors as the best evidence of the position of the original Private Claim Line.

Signed by [Signature]
Surveyor's Michigan License No. 37281

Date 12-15-99