

RC 1192

LI 26992 PA 879

LAND CORNER RECORDATION CERTIFICATE
Filing Requirement of Act 74, Mich. P.A. 1970

For corners in

Wayne
 (County)

Located In:
 City of Detroit

OTHER
 Corner Code # 4

- | | | |
|------------------------------------|---|-------------|
| 1. Public Land Survey | T <u>25</u> R <u>12E</u> | <u>004</u> |
| | T <u> </u> R <u> </u> | <u> </u> |
| | T <u> </u> R <u> </u> | <u> </u> |
| | T <u> </u> R <u> </u> | <u> </u> |
| 2. Property Controlling in Section | S <u> </u> T <u> </u> R <u> </u> | <u> </u> |
| | S <u> </u> T <u> </u> R <u> </u> | <u> </u> |
| 3. Miscellaneous | S <u> </u> T <u> </u> R <u> </u> | <u> </u> |
| Property in Sec. | S <u> </u> T <u> </u> R <u> </u> | <u> </u> |

Compliance with
 ACT 345, P.A. 1990

APPROVED ON: 11-18-93 JPJ
 WAYNE COUNTY REMONUMENTATION
 PEER GROUP COMMITTEE


Register of Deeds Stamp & File Number

4. Lot No. , Recorded Plat
 5. Private Claims Point common to W. line RC/A and line 5' South of N. line
Jefferson Ave. on Randolph

I, Martin C. Dunn, in a field survey on November 3, 19 93, do hereby certify that under requirements of P.A. 74, Michigan P.A. of 1970, the corner points mentioned in lines 1 and 2 above were in conformance with regulations and rules therefore as required in the current manual of survey instructions of the United States Department of the Interior, Bureau of Land Management or by a decree of a Court of Law and/or that the corner points mentioned in lines 3, 4 and 5 above were in conformance with the rules of the Michigan Board of Land Surveyors or by a Decree of a Court of Law; established, re-established, monumented, re-monumented, recovered, found as expressed below:

NOTE: Not more than 4 corners, all in the same town and range, may be recorded on this certificate.

- A. Description of original monument and accessories and/or subsequent restoration:
 No corner set in original government survey

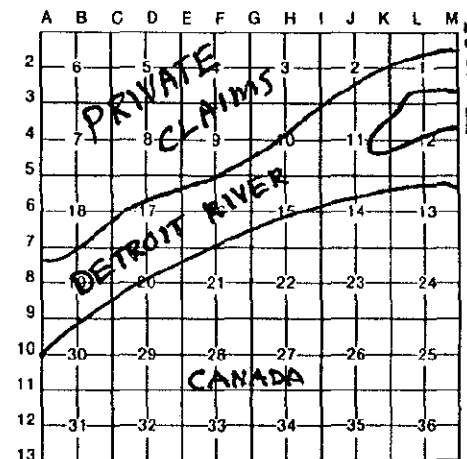

- B. Description of corner evidence found and/or method applied in restoring or reestablishing corner:

No evidence of corner

Calculated point using information obtained from City of Detroit Engineering Dept. drawing No. S-443

Placed Wayne County Remonumentation marker & Plastic Cap #30081 on 1/2" X 18" Iron monument box

NOV 30 PM 4:25
 FOREST & WILDLIFE
 RECORDS
 WAYNE COUNTY MI

- C. Description of monument for corner and accessories established to perpetuate locating the position of the corner:

Wayne Co. remonumentation marker and plastic cap #30081 on 1/2" X 18" iron within a mon. box.

Witnesses

- 1°AZ. - 88.40' Set masonry nail with W.C.R. tag west walk of Gratiot 3.95' from back curb 40' +/- of Bomac's Lounge
 85°AZ. - 71.28' Set masonry nail with W.C.R. tag east walk of Gratiot 4.65' from back curb at N. cor. Pawn Brokers Shop
 142°AZ. - 69.34' Set P.K. Nail with W.C.R. tag in asphalt sidewalk E corner Randolph and Gratiot 4.34' from back curb and 7.10' from SW cor. at Cash City Pawn Broker
 299°AZ. - 68.37' Set masonry nail with W.C.R. tag east walk of Gratiot 5.40' from back curb and 22.75 NE of SE corner of building

The selected location for this property controlling monument is accepted as a careful and faithful determination of the position as indicated.

Signed by Martin C. DunnDate 11/30/93Surveyor's Michigan License No. 30081