

RC 1197

LAND CORNER RECORDATION CERTIFICATE
Filing Requirement of Act 74, Mich. P.A. 1970

LI 26997 PA 884

For corners in

Wayne
(County)

Located In:
City of Detroit

OTHER

Corner-Code # 5

1. Public Land Survey

T 25 R 12E

#005

T R

T R

T R

2. Property Controlling in Section

S T R

S T R

3. Miscellaneous Property in Sec.

S T R

S T R

Compliance with
ACT 345, P.A. 1990

APPROVED ON: 11-18-93
WAYNE COUNTY REMONUMENTATION
PEER GROUP COMMITTEE

Register of Deeds Stamp & File Number



4. Lot No. , Recorded Plat

5. Private Claims Point on Line between FC/15 & FC/18 at centerline Jefferson
and Mt. Elliott

I, Martin C. Dunn, in a field survey on November 6, 19 93, do hereby certify that under requirements of P.A. 74, Michigan P.A. of 1970, the corner points mentioned in lines 1 and 2 above were in conformance with regulations and rules therefore as required in the current manual of survey instructions of the United States Department of the Interior, Bureau of Land Management or by a decree of a Court of Law and/or that the corner points mentioned in lines 3, 4 and 5 above were in conformance with the rules of the Michigan Board of Land Surveyors or by a Decree of a Court of Law; established, re-established, monumented, re-monumented, recovered, found as expressed below:

NOTE: Not more than 4 corners, all in the same town and range, may be recorded on this certificate.

A. Description of original monument and accessories and/or subsequent restoration:
No previously recorded corner set at this location

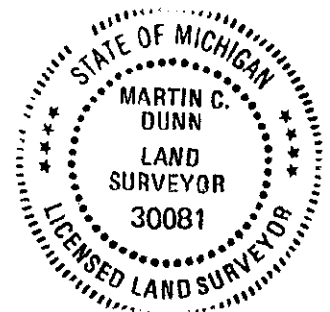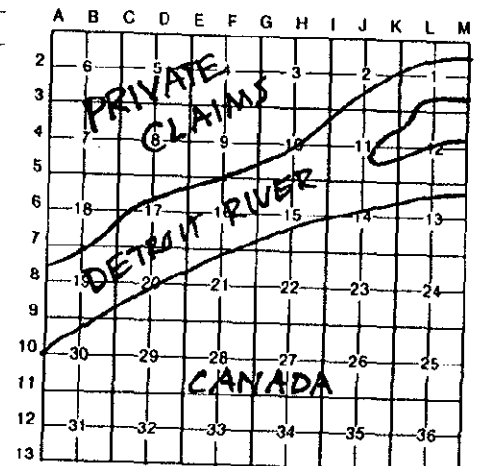

B. Description of corner evidence found and/or method applied in restoring or reestablishing corner:
Found City of Detroit monument as accepted by the City of Detroit Survey Bureau

Verified record dimensions on City of Detroit Engineers Office drawing #S-446, dated Sep. 1968

Placed Wayne County Remonumentation stamp on existing brass disc over concrete monument in monument box

33 NOV 30 PM 4-25
FOREST E. JOHNSON
REGISTER OF DEEDS
WAYNE COUNTY, MI

C. Description of monument for corner and accessories established to perpetuate locating the position of the corner:
Wayne County Remonumentation Stamp on existing brass disc over concrete monument in monument box

Witnesses
-Set masonry Nail with W.C.R. tag in walk @ SE cor. of Mt. Elliott and Jefferson 6' to L.P. 147° AZ. - 50.80'
and 10.3' to centerline of S. catch basin
-Set masonry Nail with W.C.R. tag in walk SW cor. of Mt. Elliott and Jefferson 6.32 to 198° AZ. - 66.73'
centerline light pole and 14.8 to PLC N. Hole
-Set masonry Nail with W.C.R. tag in walk @ NW cor. Mt. Elliott and Jefferson 5.35 to 277° AZ. - 100.23'
Hyd. and 23.6 to light pole on Mt. Elliott
-Found City of Detroit control monument box #250 in walk @ NE cor. of Mt. Elliott and Jefferson 4.9 to centerline of Hyd. and 4.45 to back of curb 10° AZ. - 62.36'

The selected location for this Property Controlling Monument is accepted as a careful and faithful determination of position as indicated

Signed by Martin C. DunnDate 11/17/93Surveyor's Michigan License No. 30081