## FILE DO NOT MALAND CORNER RECORDATION CERTIFICATE Filing Requirement of Act 74, Mich. P.A. 1970

SECTION

WAYNE (County)	Located In: CITY OF DETRO	
1. Public Land Survey	T 2S R 12E	0 THER CODE # 28
	TR TR	
2. Property Controlling	TR S TR	
in Section 3. Miscellaneous	S T R	
Property in Sec.	S TR	**************************************

Liber-30836 36 Page-33 12/23/1999 99590824

F.E. Youngblood, Wayne Co. Register of Deeds

Compliance with ACT 345, P.A. 1990

APPROVED ON: 12-10-99 1 WAYNE COUNTY REMONUMENTATION PEER GROUP COMMITTEE

Register of Deeds Stamp & File Number

4

5

6

7


R

10

12

4. Lot No,	Recorded Plat
5. Private Claims 91	and 733-Chene and centerline of Alexandrine

I, STEVEN E. DUNN, in a field survey on November 23, 1999, do hereby certify that under requirements of P.A. 74, Michigan P.A. of 1970, the corner points mentioned in lines 1 and 2 above were in conformance with regulations and rules therefore as required in the current manual of survey instructions of the United States Department of the Interior, Bureau of Land Management or by a decree of a Court of Law and /or that the corner points mentioned in lines 3, 4 and 5 above were in conformance with the rules of the Michigan Board of Land Surveyors or by a Decree of a Court of Law, established, re-established, monumented, re-monumented, recovered, found as expressed below:

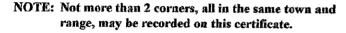

A. Description of original monument and accessories and/or subsequent restoration:

No comer originally set.

L.2, P.43

NO GOINEI OF	
PLATS:	D 45

Sheet No. 40

Sheet No. 39

Subdivision of Part of James Campau Farm, E 1/2 P.C. 91

Subdivision of the Gabriel Chene Estate, Chene Farm and Subdivision of the Chene

Estate, Chene Farm.

L.4, P.7 L.9, P.58 Subdivision of Outlot 10 Chene Farm Lothrop's Sub'n of Block No. 9 of the Chene Farm L.5, P.1 Moeller's Subdivision of Block No. 11 Chene Farm

City of Detroit Topographical Survey

City of Detroit Topographical Survey

September 13, 1872 October 5, 1874

May 19, 1875 November 3, 1880 July-1898

October 1, 1955 No date.

В.	Description of corner evidence found and/or method applied in restoring or reestablishing corner; Intersection of the east line of Private Claim 91 also being the West Line of Private Claim 733 with the centerline of Alexandrine Avenue (50' wide).

I established the location using curb splits of existing stone curb east and west and north and south and comparing measurements with found monumentation.

Description of monument for corner and accessories established to perpetuate locating the position of the corner: Intersection of the east line of the East 1/2 Private Claim 91 also being the West Line of Private Claim 733 with the centerline of Alexandrine Avenue (50' wide).

I set a 1/2" by 18" Iron Rod with an aluminum cap stamped "Wayne County Remonumentation #28408" in a new monument box in asphalt capped concrete pavement at the centerline of Alexandrine Avenue and the centerline of Chene Street.

WITNESSES:

\_ S.45°W. 50.82 Set Mag nail and Wayne County witness tag in northwest face of 24" Maple.

S.78°F 41.43 Northwest corner concrete block and brick building.

39.88 N.12°E. Center top nut hydrant. S 88°W

41.93 Centerline gas valve box. Cut "X" in concrete walk. N.28°F 37.13

THE GELECTED LOCATION IS ACCEPTED BY ME AND IS GENERALLY ACCEPTED BY PROFESSIONAL SURVEYORS AS THE BEST AVAILABLE EVIDENCE OF THE POSITION OF THE ORIGINAL CORNER. STEVEN E. TO STEVEN E. TO STEVEN E.

The selected location for this Property Controlling Monument is accepted as a careful and faithful determination of the position as indicated.

Signed by Iteren E. Dunn

PROFESSION NO. 28408 Dec. 22,1993 \_Date\_

Surveyor's Michigan License No.

FORM APPROVED BY MICHIGAN STATE BOARD OF LAND SURVEYORS, JAN. 28, 1971 REVISED MAY 14 REVISED JAN., 1983

STEVEN E.