

RECORDED
7 DEC 95 11:03 A.M.
FOREST E. YOUNGBLOOD, REGISTER
WAYNE COUNTY, MI

APR 05 1996

For corners in
COMMISSION

WAYNE (County) Located in: Corner Code #
CITY OF SOUTHGATE
(TOWNSHIP OF TAYLOR #14)
T3S R10E L-11
1. Public Land Survey T R
T R
T R
2. Property Controlling S T R
in Section S T R
3. Miscellaneous S T R
Property in Sec. S T R
4. Lot No. Recorded Plat
5. Private Claims

Compliance with
ACT 345, P.A. 1990
APPROVED ON: 12-4-95
WAYNE COUNTY REMONUMENTATION
PEER GROUP COMMITTEE
Register of Deeds Stamp & File Number

I, WALTER J. ZBIKOWSKI, in a field survey on OCTOBER 6, 1995, do hereby certify that under requirements of P.A. 75, Michigan P.A. of 1970, the corner points mentioned in lines 1 and 2 above were in conformance with regulations and rules therefore as required in the current manual of survey instructions of the United States Department of the Interior, Bureau of Land Management or by a decree of a Court of Law and/or that the corner points mentioned in lines 3, 4 and 5 above were in conformance with the rules of the Michigan Board of Land Surveyors or by a Decree of a Court of Law; established, re-established, monumented, remonumented, recovered, found as expressed below.

NOTE: Not more than 4 corners, all in the same town and range, may be recorded on this certificate.

A. Description of original monument and accessories and/or subsequent restoration.
ORIGINAL GOVERNMENT SURVEY BY JOSEPH FLETCHER, D.S. (1815-1817)
G.L.O. (1816) SET 1/4 COR AT AVERAGE DIST (DESCRIPTION OF CORNER NOT STATED IN NOTES)


WITNESSES: B. ASH 12 S 30 W 17 (11.22' REC) (GONE)
B.O. 12 N 39 E 30 (19.80' REC) (GONE)
RESURVEY AT THE DIRECTION OF ALBERT E. CHAMPNEY, DIRECTOR OF WAYNE COUNTY BUREAU OF TAXATION

W.P.A. (1930s) CROSS N-36 (#132)
WITNESSES: N 27.37' (CENTER OF) WATER GATE (MEASURED 27.46')
NE 43.00' 10" ELM (GONE)
SE 68.50' 8" ELM (GONE)
SSW 33.86' 6" ELM (GONE)
NW 70.37' (CENTER OF TOP BOLT) FIRE HYDRANT (MEASURED 70.10')

B. Description of corner evidence found and/or method applied in restoring or reestablishing corner.
FOUND A 1/2" IRON PIPE IN A ROAD BOX (GOOD) AT THE INTERSECTION OF EUREKA AND FORDLINE ROADS (BOTH CONCRETE PAVEMENTS)
DISTANCE TO K-11 MEASURED AS 2613.16'; RECORD G.L.O. (1816) DISTANCE OF 39.915 CHAINS (2634.39'); RECORD W.P.A. (1930s) DISTANCES OF 2612.97' AND 2613.19'
DISTANCE TO M-11 MEASURED AS 2611.41'; RECORD G.L.O. (1816) DISTANCE OF 39.915 CHAINS (2634.39'); RECORD W.P.A. (1930s) DISTANCES OF 2611.00' AND 2611.24'
NO OTHER LCRC OR TIES ON CS EXIST AT WAYNE COUNTY REGISTER OF DEEDS, EXCEPT FOR VARIOUS PLATS RANGING IN DATES FROM 1925 TO 1958

C. Description of monument for corner and accessories established to perpetuate locating the position of the corner.
L-11 SECTION CORNER 25, 36 T.3S., R.10E.
FOUND A 1/2" IRON PIPE IN A ROAD BOX (GOOD) AT THE INTERSECTION OF EUREKA AND FORDLINE ROADS (BOTH CONCRETE PAVEMENTS) AND IT IS ACCEPTED AS A CAREFUL AND FAITHFUL PERPETUATION OF THE POSITION OF THE ORIGINAL CORNER
WITNESSES: N.33°40'E. 54.16' CENTER OF SOUTHWEST BOLT IN BASE OF STEEL LIGHT POLE
S.35°52'E. 45.34' NAIL IN WCRC BRASS REFERENCE DISC ON WEST SIDE TRAFFIC SIGNAL GUY POLE
S.32°37'W. 80.75' P.K. NAIL IN WCRC BRASS REFERENCE DISC ON S.E. SIDE UTILITY POLE
N.34°18'W. 62.45' NAIL IN WCRC BRASS REFERENCE DISC ON N.E. SIDE UTILITY POLE

PLACED A REMONUMENTATION BRASS DISC AND PVC CAP #21586 ON ABOVE FOUND 1/2" IRON PIPE

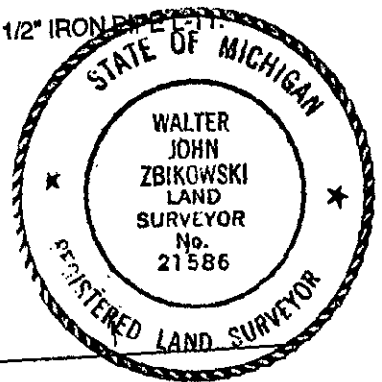

Signed by Walter J. Zbikowski Date DEC. 6, 1995
Surveyor's Michigan License No. 21586

95261582

4