

# LAND CORNER RECORDATION CERTIFICATE

## Filing Requirement of Act 74, Mich. P.A. 1970

For corners in

WAYNE  
(County)

Located in:  
LINCOLN PARK

Corner Code #

1. Public Land Survey

T 3 S R 11 E #003

T R

T R

T R

2. Property controlling  
in Section

S T R

S T R

3. Miscellaneous  
Property in Sec.

S T R

S T R

SECTION

Compliance with  
ACT 345, P.A. 1990

APPROVED ON: 12-13-95  
WAYNE COUNTY REMONUMENTATION  
PEER GROUP COMMITTEE

Register of Deeds Stamp &amp; File Number

1. Lot No. Recorded Plat  
3. Private Claims WEST LINE PRIVATE CLAIM No. 671

PAUL V. SCHWIMMER, in a field survey on NOVEMBER 16, 1995, do hereby certify that under requirements of P.A. 74, Michigan P.A. of 1970, the corner points mentioned in lines 1 and 2 above were in conformance with regulations and rules therefore as required in the current manual of survey instructions of the United States Department of the Interior, Bureau of Land Management or by decree of a Court of Law and/or that the corner points mentioned in lines 3, 4 and 5 above were in conformance with the rules of the Michigan Board of Land Surveyors or by Decree of a Court of Law; established, re-established, monumented, re-monumented, recovered, found as expressed below:

NOTE: Not more than 4 corners, all in the same town and range, may be recorded on this certificate

A. Description of original monument and accessories and/or subsequent restoration:

PREVIOUSLY ESTABLISHED AS POINT 'A' AND THE PLACE OF BEGINNING FOR 'FORD OAKS No. 1' RECORDED IN LIBER 58 OF PLATS, PAGE 100, WAYNE COUNTY RECORDS, WAYNE COUNTY, MICHIGAN

3. Description of corner evidence and/or method applied in restoring or reestablishing corner:

FOUND A 5/8" IRON IN AN EXISTING MONUMENT BOX AT THE INTERSECTION OF DIX AVENUE AND OUTER DRIVE. THIS POINT WAS TIED INTO A TRAVERSE THAT WE ESTABLISHED FOR THE DETERMINATION OF THE WEST LINE OF PRIVATE CLAIM No. 671.

\$ 4.00 REMONUMENTATION

\$ 7.00 DEED

26 DEC 95 3:22 P.M. RECEI


RECORDED

FOREST E. YOUNGBLOOD, REGISTER  
WAYNE COUNTY, MI

2. Description of monument for corner and accessories established to perpetuate locating the position of the corner:  
FOUND 5/8" IRON IN MONUMENT BOX ON THE WEST LINE OF PRIVATE CLAIM No. 671

N 05° W 46.50' CENTER OF MANHOLE  
S 50° E 47.72' FD. UTIL POLE WITH TAG  
S 00° E 43.31' CENTER OF MANHOLE  
S 85° E 43.35' CENTER OF MANHOLE  
S 30° W 29.45' CENTER OF MANHOLE

PLACED WAYNE COUNTY  
REMONUMENTATION DISK  
AND CAP ON IRON

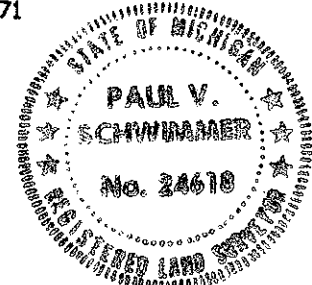

THE SELECTED LOCATION IS ACCEPTED BY THE CONTRACTOR AND IS GENERALLY ACCEPTED BY PROFESSIONAL SURVEYORS AS THE BEST AVAILABLE EVIDENCE FOR A POSITION ON THE WEST LINE OF PRIVATE CLAIM No. 671

Signed by Paul V. SchwimmerDate 12-12-95Surveyor's Michigan License No. 24618

4R  
70.  
-15