

FILE DO NOT MAIL

LAND CORNER RECORDATION CERTIFICATE
Filing Requirement of Act 74, Mich. P.A. 1970

SECTION

For corners in

Wayne Located In: City of Corner Code #
(County) Ecorse

1. Public Land Survey T R
T R
T R
T R

2. Property Controlling S T R
in Section S T R

3. Miscellaneous S T R
Property in Sec. S T-3-S R-11-E

OTHER CODE
6

Liber-30803 Page-10
99585649 12/20/1999
F.E. Youngblood, Wayne Co. Register of Deeds
RDANDEVI

Compliance with
ACT 345, P.A. 1990

APPROVED ON: 12-7-99
WAYNE COUNTY REMONUMENTATION
PEER GROUP COMMITTEE

Register of Deeds Stamp & File Number

4. Lot No. , Recorded Plat

5. Private Claims Intersection of the easterly line of P.C. 25 and westerly line
of P.C. 525 at the north Right-of-Way line of Outer Drive.

I, John N. Redash, in a field survey on December 1, 1999 do hereby state that under requirements of P.A. 74, Michigan P.A. of 1970, the corner points mentioned in lines 1 and 2 above were in conformance with regulations and rules therefore as required in the current manual of survey instructions of the United States Department of the Interior, Bureau of Land Management or by a decree of a Court of Law and/or that the corner points mentioned in lines 3, 4 and 5 above were in conformance with the rules of the Michigan Board of Land Surveyors or by a Decree of a Court of Law; established, re-established, monumented, recovered, found as expressed below:

NOTE: Not more than 2 corners, all in the same town and range, may be recorded on this certificate.

A. Description of original monument and accessories and/or subsequent restoration:

Aaron Greeley original Surveyor of Private Claims description 1809.

B. Description of corner evidence found and/or method applied in restoring or reestablishing corner:


No evidence of a corner found. Determined position of point on Private Claim Line 25 and 525 from establishment of monumentation within "Champaign Sub" Liber 29, Page 71 and "Leverenz Sub" Liber 28, Page 24, Wayne County Records. Supporting documentation and analysis of evidence is available within research dossier on file at Wayne County Register of Deeds.

C. Description of monument for corner and accessories established to perpetuate locating the position of the corner:

I placed a 1/2" iron rod with 2" diameter Wayne County Aluminum Remonumentation Cap stamped #37281 ± 1.0 foot south of back of walk.

Witnesses are as follows:

AZ 184° 57' 51"	25.80 feet	Mag nail and W.C.R. Tag northeast face of utility pole.
AZ 298° 54' 53"	88.04 feet	Cut cross southeast corner light pole base.
AZ 90° 25' 20"	65.03 feet	Cut cross southwest bolt light pole base.
AZ 149° 47' 39"	78.83 feet	Northwest corner block foundation HSE #4220

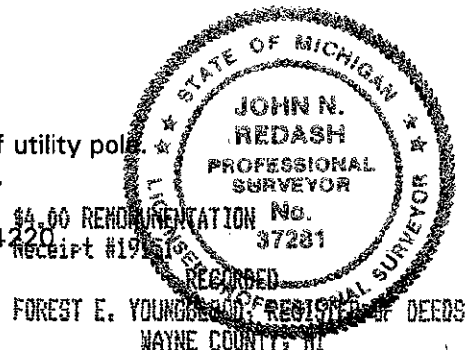

The location of this corner is accepted by myself and is generally accepted by professional surveyors as the best evidence of the position of the original Private Claim Line.

Signed by
Surveyor's Michigan License No. 37281

Date 12-15-99
\$8.00 DEED
\$7.00 DEED

FORM APPROVED BY MICHIGAN STATE BOARD OF PROFESSIONAL SURVEYORS, JAN. 28, 197
REVISED MAY 14, 197E
REVISED JAN., 198
REVISED OCT., 199