

SURVEY &
REMONUMENTATION

DEC 02 1993

RC 1113

COMMISSION

LAND CORNER RECORDATION CERTIFICATE
Filing Requirement of Act 74, Mich. P.A. 1970

For corners in

Wayne

(County)

Located In:

Corner Code =#

LI 26951 PA 744

Compliance with
ACT 345, P.A. 1990

APPROVED ON: 10-28-93
WAYNE COUNTY REMONUMENTATION
PEER GROUP COMMITTEE

Register of Deeds Stamp & File Number

1. Public Land Survey

T 4S R 9E

C-2

T R

T R

T R

2. Property Controlling
in Section

S T R

S T R

3. Miscellaneous

S T R

Property in Sec.

S T R

4. Lot No. , Recorded Plat

5. Private Claims

	A	B	C	D	E	F	G	H	I	J	K	L	M
2	6		5		4		3		2		1		
3													
4	7		8		9		10		11		12		
5													
6	18		17		16		15		14		13		
7													
8	19		20		21		22		23		24		
9													
10	30		29		28		27		26		25		
11													
12	31		32		33		34		35		36		
13													

I, Bruce Antcliff, in a field survey on August 17, 1993

do hereby certify that under requirements of P.A. 74, Michigan P.A. of 1970, the corner points mentioned in lines 1 and 2 above were in conformance with regulations and rules therefore as required in the current manual of survey instructions of the United States Department of the Interior, Bureau of Land Management or by a decree of a Court of Law and/or that the corner points mentioned in lines 3, 4 and 5 above were in conformance with the rules of the Michigan Board of Land Surveyors or by a Decree of a Court of Law; established, re-established, monumented, re-monumented, recovered, found as expressed below:

NOTE: Not more than 4 corners, all in the same town and range, may be recorded on this certificate.

A. Description of original monument and accessories and/or subsequent restoration:

GLO-Post
WPA (1930's) - Iron
LCRC (1971) - 1/2" Iron

B. Description of corner evidence found and/or method applied in restoring or reestablishing corner:

Nail in 1/2" or 3/4" Pipe; Checked distances to NE Corner and SE Cor. Sec. 6 - they checked well against the WPA Surveys.


C. Description of monument for corner and accessories established to perpetuate locating the position of the corner:

Set 4" x 36" Con. Mon. w/Wayne County Remonumentation Marker and Cap #25826 in Mon. Box

Witnesses

"+" S'y. side San. MH,
SW Cor. Block Wall,
Top Center Fire Hydrant
Nail & WCRC tag S. Side P.P.

N30W, 85.28'
N50E, 97.16'
S25E, 120.02'
N85E, 33.28'

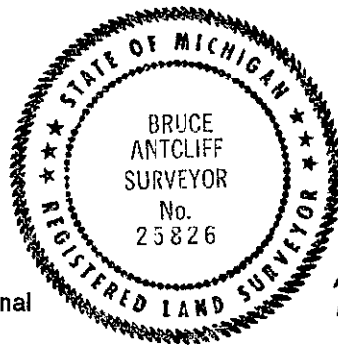

The selected location is accepted by the Contractor and is generally accepted by professional surveyors as the best available evidence of the position of the original corner.

Signed by Bruce Antcliff Date 11-10-93

Surveyor's Michigan License No. 25826