

# SURVEY & REMONUMENTATION

## RC 1585

APR 25 1995

### LAND CORNER RECORDATION CERTIFICATE Filing Requirement of Act 74, Mich. P.A. 1970

For corners in **COMMISSION**

LI27800PA652

<u>WAYNE</u> (County)	Located in: Huron Township	Corner Code #
1. Public Land Survey	T <u>4S</u> R <u>9E</u>	<u>E-8</u>
	T <u>    </u> R <u>    </u>	<u>    </u>
	T <u>    </u> R <u>    </u>	<u>    </u>
	T <u>    </u> R <u>    </u>	<u>    </u>
2. Property Controlling in Section	S <u>    </u> T <u>    </u> R <u>    </u>	<u>    </u>
	S <u>    </u> T <u>    </u> R <u>    </u>	<u>    </u>
3. Miscellaneous Property In Sec.	S <u>    </u> T <u>    </u> R <u>    </u>	<u>    </u>
	S <u>    </u> T <u>    </u> R <u>    </u>	<u>    </u>

Compliance with  
ACT 345, P.A. 1990  
APPROVED ON: 12-7-94 *WJ*  
WAYNE COUNTY REMONUMENTATION  
PEER GROUP COMMITTEE

Register of Deeds Stamp & File Number

RC 1585

4. Lot No. \_\_\_\_\_, Recorded Plat \_\_\_\_\_  
5. Private Claims \_\_\_\_\_

I, Randy Kolehhouse, in a field survey on July 27 19 94, do hereby certify that under requirements of P.A. 74 Michigan P.A. of 1970, the corner points mentioned in lines 1 and 2 above were in conformance with regulations and rules therefore as required in the current manual of survey instructions of the United States Department of the Interior, Bureau of Land Management or by a decree of a Court of Law and/or that the corner points mentioned in lines 3, 4 and 5 above were in conformance with the rules of the Michigan Board of Land Surveyors or by a Decree of a Court of Law; established, re-established, monumented, re-monumented, recovered, found as expressed below:

**NOTE:** Not more than 4 corners, all in the same town and range, may be recorded on this certificate.

**A. Description of original monument and accessories and/or subsequent restoration:**

E-8	1817	G.L.O. Notes	N/A	Post
	1930's	WPA Notes	N/A	Iron
	1965	MDSH	N/A	Iron Pipe
	1973	WORC Notes	N/A	3/4" Iron
	1977	MDSH	N/A	5/8" Rod in Conc. in Box
	1977	L.C.R.C. L. 19705 P. 96	Hobgood	5/8" Rod in Conc. in Box
	1987	L.C.R.C. L. 23239 P. 953	Timmons	Mon. in Hand Hole
	1990	Cert. Survey D.E. Co.	Stephens	1/2" Iron Bar in Box
	1992	Cert. Survey Unrecorded	Stephens	1/2" Iron Bar in Box

**B. Description of corner evidence found and/or method applied in restoring or reestablishing corner:**

E-8 Found a concrete monument in a monument box in the C/L of Bell Road (asphalt). All witnesses from above have been destroyed due to construction. This corner was raised to road surface during 1992-93 - reconstruction of Bell Road by WW Engineering & Science (EARTH TECH) who set reference points to re-establish the corner location after construction.

Measures North to E-7 = 2638.76' (G.L.O. = 2640') (WPA = 2638.30' S-20 & 2639.37' S-21)


Measures South to E-9 = 2589.63' (G.L.O. = 2640') (WPA = 2589.38' S-20 & 2589.89' S-21) (DET = 2589.64') COR. LOCATED BY DEEDS

\$ 13.00 MISCELLANEOUS RECORDING  
28 DEC 94 9:39 A.M. RECEIPT 16P  
RECORDED  
WAYNE COUNTY, MI

**C. Description of monument for corner and accessories established to perpetuate locating the position of the corner:**

E-8 I set an aluminum cap stamped "Wayne Co. Remon." on existing concrete monument in an existing monument box.

"+" N End Conc. Headwall S 80° E 35.45'  
P.K. SE Face Util. Pole S 40° W 90.74'  
C/L Top Nut Hyd. S 72° W 83.83'  
"+" N End Conc. Headwall N 85° W 41.46'

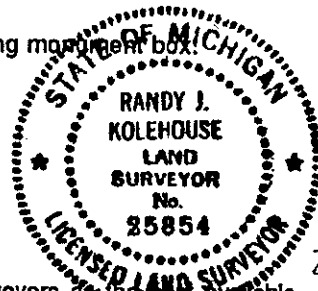

The selected location is accepted by the Contractor and is generally accepted by professional surveyors as the best available evidence of the position of the original corner.

Signed by Randy J. Kolehhouse

Date 12/14/94

Surveyor's Michigan License No. 25854