

RC 1432
LAND CORNER RECORDATION CERTIFICATE
Filing Requirement of Act 74, Mich. P.A. 1970

LI27794PA290

PC-552 Page 1

For corners in

Wayne

County

Located in:

MONGUAGON

Corner Code

1. Public Land Survey

T 4 S R 11 E

~~N.W. PC-552~~

T R

#003

T R

T R

2. Property Controlling
In Section

S T R

S T R

3. Miscellaneous

S T R

Property in Sec.

S T R

Compliance with
ACT 345, P.A. 1990

APPROVED ON: 12/9/94 WCAO.
WAYNE COUNTY REMONUMENTATION
PEER GROUP COMMITTEE

Register of Deeds Stamp and File Number

4. Lot No. Recorded Plat

5. Private Claims NW 1/4 - 552

A B C D E F G H I J K L M

2	6	5	4	3	2	1							
3													
4	7	8	9	10	11	12							
5													
6	18	17	16	15	14	13							
7													
8	19	20	21	22	23	24							
9													
10	30	29	28	27	26	25							
11													
12	31	32	33	34	35	36							
13													

I, Kenneth S. Wilkerson in a field survey on 11/29/1994

do hereby certify that under requirements of P.A. 74, Michigan P.A. of 1970, the corner points mentioned in lines 1 and 2 above were in conformance with regulations and rules therefore as required in the current manual of survey instructions of the United States Department of the Interior, Bureau of Land Management, or by a decree of a Court of Law and/or that the corner points mentioned in lines 3, 4 and 5 above were in conformance with the rules of the Michigan Board of Land Surveyors or by a Decree of a Court of Law, established, re-established, monumented, re-monumented, recovered, found as expressed below.

NOTE: Not more than 4 corners, all in the same town and range, may be recorded on this certificate.

A. Description of original monument and accessories and/or subsequent restorations:

01/01/1817

G.L.O.

CORNER WAS NEVER SET ON THE ORIGINAL SURVEY

12/16/1992

CONDON

24590

1086

CONC. MON. IN HAND HOLE
AFTER REPAVING

1 P.K. NAIL & CAP IN SW SIDE U. P. N60W 87.85'

(Witnesses Continued on Back ...)

B. Description of corner evidence found and/or method applied in restoring or reestablishing corner:

1/2" iron rod in conc. mon. in mon. box w/cover in asph. pvmt at CL Ferry Rd.

C. Description of monument for corner and accessories established to perpetuate locating the position of the corner:

11/29/1994

Wilkerson

21584

O.I.M.

Remon

SET WCR WASHER AND CAP OVER CORNER

SET W.C.R. WASHER & CAP ON CORNER

1 FD. P.K. NAIL AND CAP. SET WCR TAG SW/S P.P. N 60 W 87.80'

2 FD. P.K. NAIL & CAP. SET WCR TAG S/S P.P. N 50 E 56.85'

3 FD. 50" OAK W/P.K. SET WCR TAG N/S 50" OAK S40E 60.60'

4 FD. 1" IRON PIPE IN CONC. MON. S. SIDE FERRY RD. AND W. SIDE

\$ 16.00 MISCELLANEOUS RECORDING

21 DEC 94 3:18 P.M. RECEIPT# 93A

RECORDED

FOREST E. YOUNGBLOOD, REGISTER OF DEEDS
WAYNE COUNTY, MI

We conclude that after careful study of the record documentation and field observations, that this corner is accepted as the best available evidence of the position of the original corner


Signed by

Drafted by Kenneth S. Wilkerson

Surveyor's Michigan License No. 21584

Date

Orchard, Hiltz and McCliment, Inc. 34935 Schoolcraft Road Livonia, MI 48150

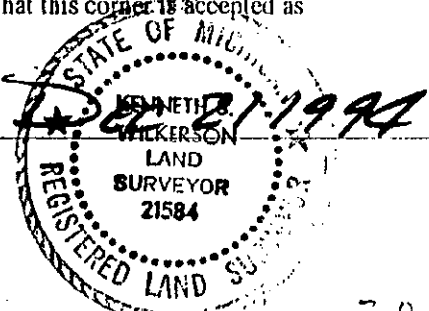

Z R
14 M. 10.30.

A (Continued) Description of original monument and accessories and/or subsequent restorations:

12/16/1992	CONDON	24590	1086	CONC. MON. IN HAND HOLE AFTER REPAVING
------------	--------	-------	------	---

- 2 P.K. NAIL & CAP IN S SIDE U.P. N50E 56.80'
- 3 P.K. NAIL IN N. SIDE 39" OAK S40E 59.23'
- 4 CONC. MON S SIDE OF FERRY RD. S45W 86.60'